

Harrison  
B 146

MISSISSIPPI  
BOARD OF WATER COMMISSIONERS  
416 North State Street  
Jackson, Mississippi 39201

CODED

WATER WELL DRILLERS LOG

April 29 1983 Parnell Anderson Harrison  
date well completed firm name county well located

LANDOWNER	Description of formations encountered	from	to
George Alexander	top soil	0	2
Rt 1 Box 154	clay	2	24
Saucier, MS 39574	sand	24	38
(mailing address)	blue clay	38	250
	sand	250	298

WELL LOCATION:  
sec. 14 T. 5 S R. 12 W  
5 miles S of Saucier  
(distance) (direction) (nearest town)

CODED

WELL PURPOSE: Home  
(home, irrigation, municipal, industrial)

- WELL COMPLETION DATA:
- (1) diameter (inches) 2"
  - (2) total depth (feet) 298'
  - (3) static water level (feet) 58' below top of ground.
  - (4) casing PVC (material), (depth)
  - (size) if telescope see back.
  - (5) screen 10 (length), 288 (depth to top)
  - 1" (size), PVC (material)
  - (6) pump 1 (HP), 10 (yield gpm)
  - Electric (type power)
  - (7) electric log NO (yes or no)
  - (organization running log)

(8) how well bottom plugged capped

DEPT. OF NATURAL RESOURCES  
BUREAU OF LAND & WATER RESOURCES


DRILLERS REMARKS:

JUN - 2 1983

RECEIVED

If well telescopes please sketch and show depths.

GROUND LEVEL

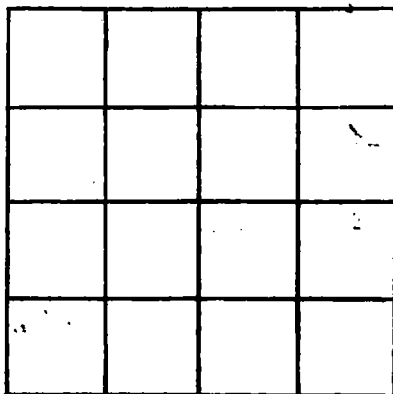

SECTION \_\_\_\_\_

Please indicate well location X.

ADDITIONAL INFORMATION

If more than one screen,  
show locations of each on sketch.