

MISSISSIPPI DEPARTMENT OF NATURAL RESOURCES
Bureau of Land and Water Resources
 Southport Mall
 P.O. Box 10631
 Jackson, Mississippi 39209
WATER WELL DRILLERS LOG

CODED

Harrison
B147

FEB 23 1983 McGill Wells INC. Harrison
 date well completed firm name county well located

LANDOWNER: JOHN BOND
RT #2 BOX 72
Saucier, MS
 (mailing address)

description of formations encountered	from	to
<u>Mud</u>	<u>0</u>	<u>190</u>
<u>SAND</u>	<u>190</u>	<u>210</u>
<u>SAND</u>	<u>210</u>	<u>230</u>
<u>SAND</u>	<u>230</u>	<u>250</u>

WELL LOCATION:
 sec. 13.5 N R. 10 E
15 miles N of Gupt
 (distance) (direction) (nearest town)

WELL PURPOSE: None
 (home, irrigation, municipal, industrial)

CODED

WELL COMPLETION DATA:

(1) diameter (inches) 2"

(2) total depth (feet) 250'

(3) static water level (feet) 80' below top of ground.

(4) casing PVC 240'
 (material) (depth)

2" if telescope see back.
 (size)

(5) screen 10' 240'
 (length) (depth to top)

2" PVC
 (size) (material)

(6) pump 1 8-10
 (HP) (yield gpm)

elec.
 (type power)

(7) electric log —
 (yes or no)

—
 (organization running log)


(8) how well bottom plugged sand
seal.

DRILLERS REMARKS:

MISSISSIPPI DEPARTMENT OF NATURAL RESOURCES
 BUREAU OF LAND AND WATER RESOURCES
 AUG 11 1983
 AUG 10 1983
RECEIVED

If well telescopes please sketch and show depths.

GROUND LEVEL

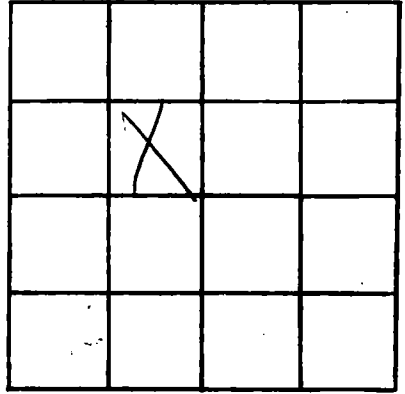

SECTION 13

Please indicate well location X.

ADDITIONAL INFORMATION

Lined area for additional information.

If more than one screen, show locations of each on sketch.