

MISSISSIPPI DEPARTMENT OF NATURAL RESOURCES

Bureau of Land and Water Resources

Southport Mall

P.O. Box 10631

Jackson, Mississippi 39209

WATER WELL DRILLERS LOG

CODED

Hansir
B148

July 8 1983 Duncan Well Drilling Harrison
date well completed firm name county well located

LANDOWNER: Herman Sadner
Rt. 1 Box 162
Saucier, Ms.
(mailing address)

description of formations encountered	from	to
<u>Top Sand</u>	<u>0</u>	<u>20</u>
<u>Sand Blue + Red Clay</u>	<u>30</u>	<u>80</u>
<u>good sand</u>	<u>90</u>	<u>100</u>

WELL LOCATION:
sec. 2 T. 5 N. R. 12 E.
15 miles NW of Lynon
(distance) (direction) (nearest town)

CODED

WELL PURPOSE:
(home, irrigation, municipal, industrial)

WELL COMPLETION DATA:
(1) diameter (Inches) 3"
(2) total depth (feet) 100 ft
(3) static water level (feet) 22' below top of ground.
(4) casing PVC, 90'
(material) (depth)
(size) If telescope see back.
(5) screen 10', 90'
(length) (depth to top)
2", PVC
(size) (material)
(6) pump (HP) (yield gpm)
(type power)
(7) electric log (yes or no)
(organization running log)
(8) how well bottom plugged land
shack

DEPT. OF NATURAL RESOURCES
BUREAU OF LAND & WATER RESOURCES


AUG 15 1983

RECEIVED

DRILLERS REMARKS: Owner
has his own
pump

If well telescopes please sketch and show depths.

GROUND LEVEL

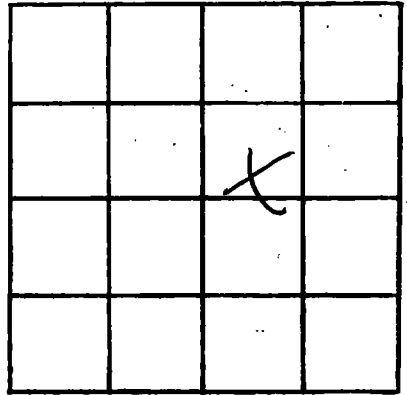

SECTION 2

Please indicate well location X.

ADDITIONAL INFORMATION

If more than one screen,
show locations of each on sketch.