

MISSISSIPPI DEPARTMENT OF NATURAL RESOURCES

Bureau of Land and Water Resources

Southport Mall

P.O. Box 10631

Jackson, Mississippi 39209

WATER WELL DRILLERS LOG

Harrison  
B 149

10

CODED

3/26/83  
 date well completed

Lipman Well  
 firm name

Harrison  
 county well located

LANDOWNER: Bill James  
Rt. 2, Box A-2  
Saucier 39574  
 (mailing address)

description of formations encountered	from	to
Red sand & clay	0	60
Crumb clay	60	140
Blue clay	140	200
Blue clay fine	200	278
sand		
Good sand & gravel	278	301

WELL LOCATION:  
 sec. 24 T 4 N R 12 E  
5 S W  
2 miles S of Saucier  
 (distance) (direction) (nearest town)

WELL PURPOSE: Home  
 (home, irrigation, municipal, industrial)

- WELL COMPLETION DATA:
- (1) diameter (inches) 2"
  - (2) total depth (feet) 301
  - (3) static water level (feet) 30' below above top of ground.
  - (4) casing PVC, 291'  
 (material) (depth)  
2" If telescope see back.  
 (size)
  - (5) screen 10', 291'  
 (length) (depth to top)  
2" PVC  
 (size) (material)
  - (6) pump N/A, N/A  
 (HP) (yield gpm)  
N/A  
 (type power)
  - (7) electric log NO  
 (yes or no)  
NO  
 (organization running log)
  - (8) how well bottom plugged sand  
shark

CODED

DEPT. OF NATURAL RESOURCES  
 BUREAU OF LAND & WATER RESOURCES


AUG 29 1983

RECEIVED

DRILLERS REMARKS:

If well telescopes please sketch and show depths.

GROUND LEVEL

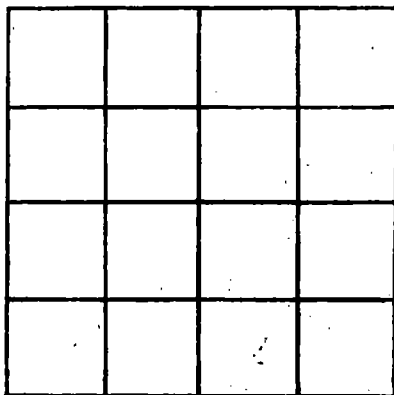

SECTION \_\_\_\_\_

Please indicate well location X.

ADDITIONAL INFORMATION

If more than one screen, show locations of each on sketch.