

MISSISSIPPI DEPARTMENT OF NATURAL RESOURCES

Bureau of Land and Water Resources

Southport Mall

P.O. Box 10631

Jackson, Mississippi 39209

WATER WELL DRILLERS LOG

CODED

Harrison
B 150

4/13/83
date well completed

Lyman Well
firm name

Harrison
county well located

LANDOWNER: Oscar Aguirre
Old Hwy 49
Saucier 39574
(mailing address)

description of formations encountered	from	to
Red Sand	0	50
White Clay & Grey Gumbo	50	150
Blue Clay	150	194
Medium Grained Sand	194	245

WELL LOCATION:
sec. 24 T. 4 N. R. 12 E.
2 50 S. 5 Saucier
(distance) miles (direction) of (nearest town)

CODED

WELL PURPOSE: home
(home, irrigation, municipal, industrial)

- WELL COMPLETION DATA:
- (1) diameter (inches) 2"
 - (2) total depth (feet) 245'
 - (3) static water level (feet) 58 below above top of ground.
 - (4) casing PVC 235'
(material) (depth)
2" If telescope see back.
(size)
 - (5) screen 10' 235'
(length) (depth to top)
2" PVC
(size) (material)
 - (6) pump 1 12
(HP) (yield gpm)
electric
(type power)
 - (7) electric log No
(yes or no)
NO
(organization running log)
 - (8) how well bottom plugged sand
Shark

DEPT. OF NATURAL RESOURCES
BUREAU OF LAND & WATER RESOURCES


AUG 29 1983

RECEIVED

DRILLERS REMARKS:

If well telescopes please sketch and show depths.

GROUND LEVEL

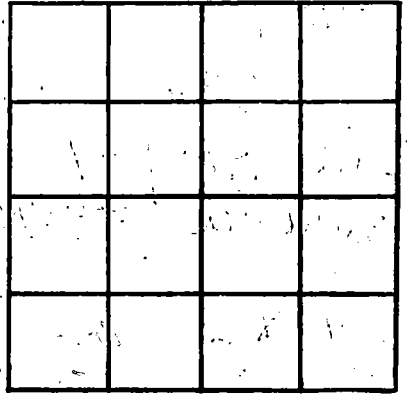

SECTION _____

Please indicate well location X.

ADDITIONAL INFORMATION

If more than one screen, show locations of each on sketch.