

MISSISSIPPI DEPARTMENT OF NATURAL RESOURCES

Bureau of Land and Water Resources

Southport Mall

P.O. Box 10631

Jackson, Mississippi 39209

WATER WELL DRILLERS LOG

CODED

Harrison
B151

MAY 5 1987 ET + B Well Co HARRISON
date well completed firm name county well located

LANDOWNER:
CRAWFORD - D
Rt 3 SAUCIER MS
(mailing address)

WELL LOCATION:
sec. 23 T. 5 N R. 12 E
3 miles SSW of SAUCIER
(distance) (direction) (nearest town)

WELL PURPOSE:
(home, irrigation, municipal, industrial)

WELL COMPLETION DATA:
(1) diameter (inches) 2
(2) total depth (feet) 95
(3) static water level (feet) 5 below above top of ground.
(4) casing PLASTIC 85 (material) (depth) (size) if telescope see back.
(5) screen 10 85 (length) (depth to top)
SC 80 2 PLASTIC (size) (material)
(6) pump 1 104 (HP) (yield gpm)
ELEC (type power)
(7) electric log (yes or no)
(organization running log) SAUCIER SERV
(8) how well bottom plugged

description of formations encountered	from	to
<u>SOIL TOP</u>	<u>0</u>	<u>18</u>
<u>SAND</u>	<u>10</u>	<u>21</u>
<u>SAND</u>	<u>20</u>	<u>30</u>
<u>CLAY</u>	<u>30</u>	<u>35</u>
<u>SAND & FINE</u>	<u>35</u>	<u>45</u>
<u>SAUCIER FINE</u>	<u>45</u>	<u>55</u>
<u>" "</u>	<u>55</u>	<u>65</u>
<u>" "</u>	<u>65</u>	<u>75</u>
<u>SAUCIER MED</u>	<u>75</u>	<u>85</u>
<u>COURSE</u>	<u>85</u>	<u>95</u>
<u>CLAY BOTTOM</u>		

CODED

DEPT. OF NATURAL RESOURCES
BUREAU OF LAND & WATER RESOURCES


MAY 27 1987

RECEIVED

DRILLERS REMARKS:

If well telescopes please sketch and show depths.

GROUND LEVEL

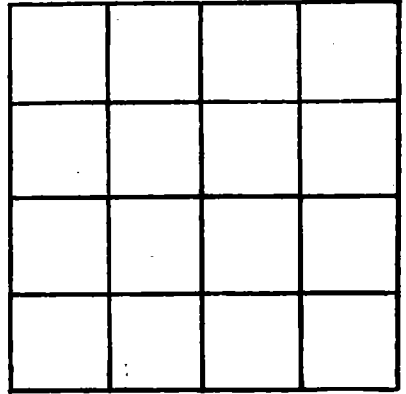

SECTION _____

Please indicate well location X.

ADDITIONAL INFORMATION

If more than one screen, show locations of each on sketch.