

MISSISSIPPI DEPARTMENT OF NATURAL RESOURCES

Bureau of Land and Water Resources

Southport Mall

P.O. Box 10631

Jackson, Mississippi 39209

WATER WELL DRILLERS LOG

Harrison
B 154 154

6/12 1982 Lyman Well Co. Harrison City
 date well completed firm name county well located

LANDOWNER: Charles Cates
Rt. 1, Box 791
Saucier, Ms 39574
 (mailing address)

description of formations encountered	from	to
fine sand	0	30
Gravel		
Clay	30	115
Medium Sand	115	152

WELL LOCATION: S 12
 sec 13 T 6 N R 4 E
2 miles 5 miles of Saucier
 (distance) (direction) (nearest town)

WELL PURPOSE: HOME
 (home irrigation, municipal, industrial)

WELL COMPLETION DATA:

(1) diameter (inches) 4"

(2) total depth (feet) 152'

(3) static water level (feet) 145' below above top of ground

(4) casing PVC 142
 (material) (depth)
4"
 (size) If telescope see back.

(5) screen 10' 152
 (length) (depth to top)
4" PVC
 (size) (material)

(6) pump 1 34
 (HP) (yield gpm)
Elect.
 (type power)

(7) electric log NO
 (yes or no)
NO
 (organization running log) Sand Shark

(8) how well bottom plugged Sand Shark

DEPT. OF NATURAL RESOURCES
 BUREAU OF LAND & WATER RESOURCES


JUL 20 1982

RECEIVED

DRILLERS REMARKS:

If well telescopes please sketch and show depths.

GROUND LEVEL

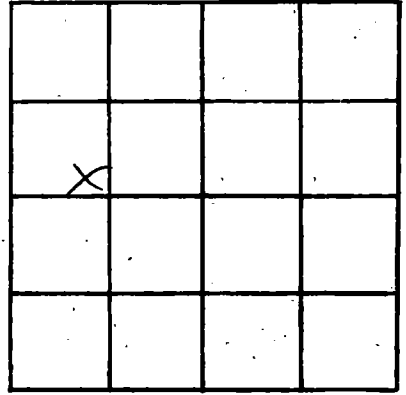

SECTION 13

Please indicate well location X.

ADDITIONAL INFORMATION

If more than one screen,
show locations of each on sketch.