

MISSISSIPPI DEPARTMENT OF NATURAL RESOURCES

Bureau of Land and Water Resources

Southport Mall

P.O. Box 10631

Jackson, Mississippi 39209

WATER WELL DRILLERS LOG

HARRISON
D.B. 155
11/4/80
11/4/80

date well completed

firm name

county well located

Lyman Well Co

Harrison

LANDOWNER:

description of formations encountered

from

to

J. D. Braxton
Ramsey Lane
Saucier, MS
(mailing address)

yellow clay 0 12
red sand & clay 12 30
grey clay & blue clay 30 260
sand fine 260 330

WELL LOCATION:

sec. 12 T. 5 N. R. 12 E.
1 miles W of Saucier
(distance) (direction) (nearest town)

WELL PURPOSE:

(home, irrigation, municipal, industrial)

WELL COMPLETION DATA:

- (1) diameter (inches) 3 3/8" 2"
- (2) total depth (feet) 330'
- (3) static water level (feet) 65' below above top of ground.
- (4) casing PVC 320'
(material) (depth)
2"
(size) if telescope see back.
- (5) screen 10' 320'
(length) (depth to top)
2" PVC
(size) (material)
- (6) pump 1 13
(HP) (yield gpm)
electric
(type power)
- (7) electric log No
(yes or no)

(organization running log)

(8) how well bottom plugged sand
shark

DRILLERS REMARKS:

lot of sand
lot of sand very fine


DEPT. OF NATURAL RESOURCES
BUREAU OF LAND & WATER RESOURCES

FEB 19 1981

RECEIVED

If well telescopes please sketch and show depths.

GROUND LEVEL

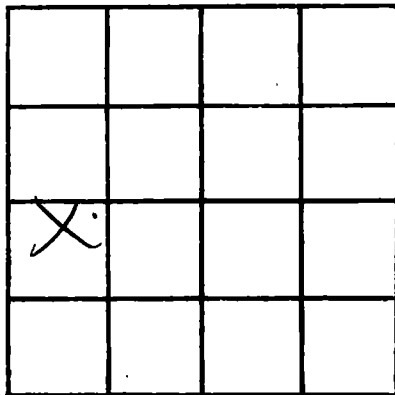

SECTION 12

Please indicate well location X.

ADDITIONAL INFORMATION

If more than one screen, show locations of each on sketch.