

MISSISSIPPI DEPARTMENT OF NATURAL RESOURCES

Bureau of Land and Water Resources

Southport Mall

P.O. Box 10631

Jackson, Mississippi 39209

WATER WELL DRILLERS LOG

HARRISON  
 Q B156  
 4/21/81  
 4/21/81

date well completed

firm name

county well located

Lyman Well Co.

Harrison

LANDOWNER:

Charles Stewart

East Wortham Rd.

Sauceur, Ms

(mailing address)

description of formations encountered

from

to

yellow clay & sand gravel	0	15
yellow sand gravel	15	45
gray & blue clay	45	110
yellow sand	110	158

WELL LOCATION:


sec 26 T 5 N R 12 W  
 20 miles (distance) W N of Gaffney (direction) (nearest town)

WELL PURPOSE:

(home, irrigation, municipal, industrial)  
 Home

WELL COMPLETION DATA:

- (1) diameter (inches) 2"
- (2) total depth (feet) 158'
- (3) static water level (feet) 57 below above top of ground
- (4) casing PVC 148' (material) (depth)
- (5) screen 2" 10' 148' (size) (length) (depth to top)
- (6) pump 1 PVC (HP) (material)
- (7) electric log electric (type power)
- (8) electric log No (yes or no)
- No (organization running log)
- (8) how well bottom plugged sand shark

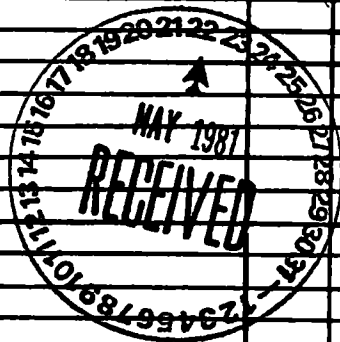

DRILLERS REMARKS:

