

HAR.

MISSISSIPPI BOARD OF WATER COMMISSIONERS

G 252904

B160

CODED

6-17-63

WATER WELL DRILLERS LOG

Date: 6-14, 1963, Driller: C. T. SWITZER WELL CO. County: Harrison

(Name)

(1) Owner of Land: Bobby Radner  
(Name)

Sawani, Miss.  
(Address)

SEN  
(2) Location: SE 1/4, NW 1/4, Sec. 14 T55R12E  
Sub. DIU

\_\_\_\_\_ miles \_\_\_\_\_ of \_\_\_\_\_  
(distance) (direction) (Nearest Town)

(3) Topography:  (Hilly)  (Flat)  (Level)

(4) Purpose of Well: Domestic  
(Domestic Irrigation, Municipal, Industrial, Other)

Description & Color of Materials Sand, Clay, Red Clay, Shell, etc.	Thick- ness Feet	Depth Feet
Clay	20	20
band of pea gravel	20	40
band	20	60
Clay	50	110
band	155	160
Clay	160	220
Clay w/ few sand str.	220	240
band, fine	240	260
band, good	260	294

Information upon completion of well:

(1) Diameter 2 inches.

(2) Total Depth 294 feet.

(3) Water Level 65' feet below top of ground.

(4) Cased to 294', Size 2"

(5) Screen: Size 2", Length 10'

(6) Were any formations sealed against pollution?  
 yes,  no.


Sawani Rd.

W of Sawani

If YES depth of formation \_\_\_\_\_

Why Health Dept. requirement

Drillers Remarks: \_\_\_\_\_

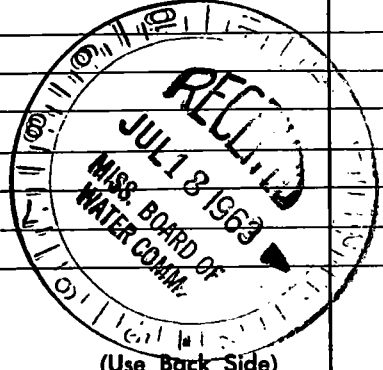

Well No.

