

MISSISSIPPI DEPARTMENT OF NATURAL RESOURCES

Bureau of Land and Water Resources

Southport Mall

P.O. Box 10631

Jackson, Mississippi 39209

WATER WELL DRILLERS LOG

B161
 HARRISON
 1-28-83

CODED

1/28/83 19 Lyman Well Co. Harrison
 date well completed firm name county well located

LANDOWNER: Billy J. Hickman
Rt. 3, Box 120
Saucier, MS 39574
 (mailing address)

Description of formations encountered	from	to
Red sand & Red Clay & Gravel	0	70
Blue Gumby Clay	70	130
Hard Blue Clay	130	180
medium hard sand	180	210

WELL LOCATION:
 sec. 4 T. 5 N. R. 12 E
5 miles W of Saucier
 (distance) (direction) (nearest town)

WELL PURPOSE: Home
 (home, irrigation, municipal, industrial)

WELL COMPLETION DATA:

(1) diameter (inches) 2"

(2) total depth (feet) 210'

(3) static water level (feet) 100' below above top of ground.

(4) casing PVC, 200'
 (material) (depth)

2"
 (size) if telescope see back.

(5) screen 10', 200'
 (length) (depth to top)

2", PVC
 (size) (material)

(6) pump N/A (yield gpm)
 (HP)

(type power)

(7) electric log NO
 (yes or no)
NO
 (organization running log)

(8) how well bottom plugged sand
shark

DEPT. OF NATURAL RESOURCES
 BUREAU OF LAND & WATER RESOURCES


MAY 11 1984

RECEIVED

DRILLERS REMARKS:

If well telescopes please sketch and show depths.

GROUND LEVEL

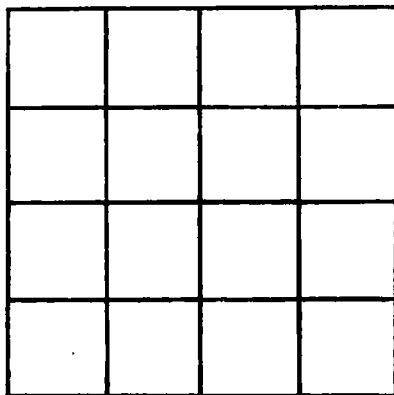

SECTION _____

Please indicate well location X.

ADDITIONAL INFORMATION

If more than one screen, show locations of each on sketch.