

MISSISSIPPI DEPARTMENT OF NATURAL RESOURCES

Bureau of Land and Water Resources

Southport Mall

P.O. Box 10631

Jackson, Mississippi 39209

WATER WELL DRILLERS LOG

~~29-83~~ B162
~~29-83~~ HARRISON
 2-9-83

CODED

2/9/83
 date well completed

Lyman Well
 firm name

Harrison
 county well located

LANDOWNER: Art Reeder
 P.O. Box 205
 Saucier 39574
 (mailing address)

description of formations encountered	from	to
Gravel	0	20
Red Clay & Sand	20	60
Blue Clay	60	150
Fine Sand & Clay	150	200
Blue Clay	200	273
Good Sand	273	300

WELL LOCATION:
 sec. 24 T. 5 N. R. 12 E.
 2 miles S of Saucier
 (distance) (direction) (nearest town)

WELL PURPOSE: Home
 (home, irrigation, municipal, industrial)

- WELL COMPLETION DATA:
- (1) diameter (inches) 2"
 - (2) total depth (feet) 301'
 - (3) static water level (feet) 20' below top of ground.
 - (4) casing PVC, 291' (material), (depth)
 2" (size) if telescope see back.
 - (5) screen 10', 291' (length), (depth to top)
 2" (size), PVC (material)
 - (6) pump N/A (HP), N/A (yield gpm)
 N/A (type power)
 - (7) electric log No (yes or no)
 No (organization running log)
 - (8) how well bottom plugged Sand
 Shark

DEPT. OF NATURAL RESOURCES
 BUREAU OF LAND & WATER RESOURCES


MAY 11 1984

RECEIVED

DRILLERS REMARKS:

If well telescopes please sketch and show depths.

GROUND LEVEL

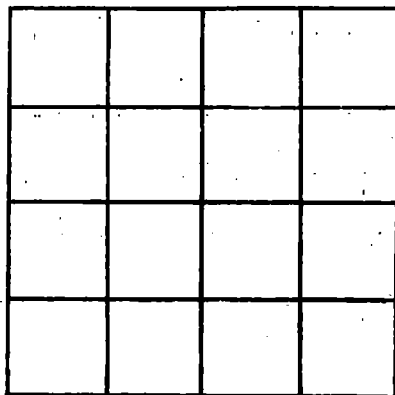

SECTION _____

Please indicate well location X.

ADDITIONAL INFORMATION

If more than one screen, show locations of each on sketch.