

MISSISSIPPI DEPARTMENT OF NATURAL RESOURCES

Bureau of Land and Water Resources

Southport Mall

P.O. Box 10631

CODED

Jackson, Mississippi 39209

WATER WELL DRILLERS LOG

B1163
HARRISON
6-29-84

(Doris)

6/29 1984 Braden Pump & Well Harrison
date well completed firm name county well located

LANDOWNER: Linda Kay Davis
Pt. 3, Box 337
Jaucin, Ms 39574
(mailing address)

Description of formations encountered	from	to
clay	0	80
sand	80	120
blue clay	120	140
blue clay	140	160
sand clay	160	200
sand	200	240
green clay	240	280
sand	280	340

WELL LOCATION:
sec. 14 T. 5 S. R. 12 E.
4 miles S.E. of Jaucin
(distance) (direction) (nearest town)

WELL PURPOSE: Home
(home, irrigation, municipal, industrial)

WELL COMPLETION DATA:
(1) diameter (inches) 4x2
(2) total depth (feet) 340
(3) static water level (feet) 51 below top of ground.
(4) casing PVC, 320 (material), (depth)
4x2 (size) if telescope see back.
(5) screen 10', 320 (length), (depth to top)
2" PVC underbar (size), (material)
(6) pump 1, 20 (HP), (yield gpm)
230V (type power)
(7) electric log no (yes or no)

(organization running log)
(8) how well bottom plugged PVC sand sharp

DRILLERS REMARKS: 10ft tailpipe

DEPT. OF NATURAL RESOURCES
BUREAU OF LAND & WATER RESOURCES

JUL 27 1984

RECEIVED

If well telescopes please sketch and show depths.


GROUND LEVEL

240'
4"
PVC

100'
2"
PVC

10' PVC
screen

10'
tail pipe

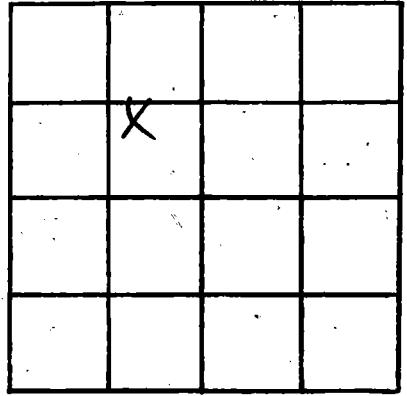

SECTION 14

Please indicate well location X.

ADDITIONAL INFORMATION

If more than one screen,
show locations of each on sketch.