

MISSISSIPPI DEPARTMENT OF NATURAL RESOURCES

Bureau of Land and Water Resources

Southport Mall

P.O. Box 10631

CODED

Jackson, Mississippi 39209

WATER WELL DRILLERS LOG

B 171
Harrison
5-28-84

5/28/84 19 Lyman Well Co Harrison
date well completed firm name county well located

LANDOWNER: Gene T. Hill
L Cuevas Rd
Saucier MS 39574
(mailing address)

description of formations encountered	from	to
<u>red clay</u>	<u>0</u>	<u>28</u>
<u>blue clay</u>	<u>29</u>	<u>37.3</u>
<u>sand</u>	<u>37.4</u>	<u>400</u>

WELL LOCATION:
sec. 28 T. 5 N R. 12 E
4 miles SW of Saucier
(distance) (direction) (nearest town)

WELL PURPOSE: Home
(home, irrigation, municipal, industrial)

- WELL COMPLETION DATA:
- (1) diameter (inches) 2"
 - (2) total depth (feet) 400'
 - (3) static water level (feet) 45 below top of ground
 - (4) casing PVC, 390'
(material) (depth)
 - 2" If telescope see back.
(size)
 - (5) screen 10', 390'
(length) (depth to top)
 - 2", PVC
(size) (material)
 - (6) pump 1, 12
(HP) (yield gpm)
 - electric
(type power)
 - (7) electric log NO
(yes or no)
NO
(organization running log)
 - (8) how well bottom plugged sand
shark


DRILLERS REMARKS: _____

DEPT. OF NATURAL RESOURCES
BUREAU OF LAND & WATER RESOURCES

DEC 10 1984
RECEIVED

If well telescopes please sketch and show depths.

GROUND LEVEL

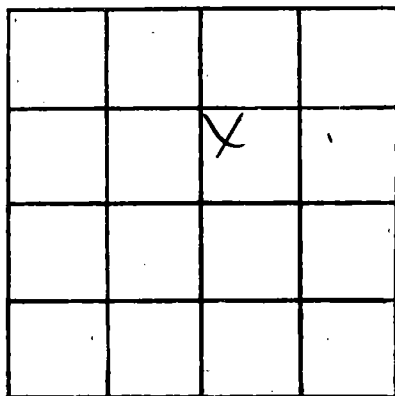

SECTION 28

Please indicate well location X.

ADDITIONAL INFORMATION

If more than one screen, show locations of each on sketch.