

MISSISSIPPI DEPARTMENT OF NATURAL RESOURCES
Bureau of Land and Water Resources

Southport Mall
P.O. Box 10631

Jackson, Mississippi 39209
WATER WELL DRILLERS LOG

CODED

Harrison
B 179
12/21/84

12/21/84 19 Lyman Well Co. Harrison
date well completed firm name county well located

LANDOWNER Paul Wyraschek

P.O. Box 2254
Gulfport, Ms 39503
(mailing address)

WELL LOCATION:

sec. 15 T-5 N R-12 E
5 miles SW of Saucier
(distance) (direction) (nearest town)

WELL PURPOSE: home
(home, irrigation, municipal, industrial)

WELL COMPLETION DATA:

- (1) diameter (inches) 4"
- (2) total depth (feet) 243'
- (3) static water level (feet) 10' ^{below}/_{above} top of ground.
- (4) casing PVC, 233'
(material) (depth)
4"
(size) If telescope see back.
- (5) screen 10', 233'
(length) (depth to top)
4" PVC
(size) (material)
- (6) pump 1 27
(HP) (yield gpm)
electric
(type power)
- (7) electric log No
(yes or no)
No
(organization running log)
- (8) how well bottom plugged sand
shark

description of formations encountered

from to

white sand 0 10
blue clay 10 108
blue clay 108 215
sand & gravel 215 243

CODED

RECEIVED


MAY 24 1985

Department of Natural Resources
Bureau of Land & Water Resources

DRILLERS REMARKS:

If well telescopes please sketch and show depths.

GROUND LEVEL

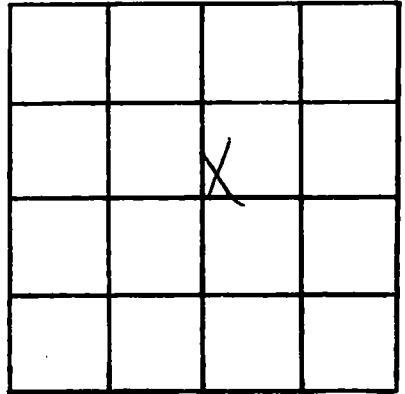

SECTION 15

Please indicate well location X.

ADDITIONAL INFORMATION

If more than one screen, show locations of each on sketch.