

MISSISSIPPI DEPARTMENT OF NATURAL RESOURCES

Bureau of Land and Water Resources

Southport Mall

P.O. Box 10631

Jackson, Mississippi 39209

WATER WELL DRILLERS LOG

CODED

Harrison  
B181  
4-29-85

4/29 1985 date well completed

Brader Pump & Well firm name

Harrison county well located

LANDOWNER: Wanda Kong  
P.O. Box 268  
Aucier, MS 39574  
(mailing address)

description of formations encountered

from to

<u>red clay</u>	<u>0</u>	<u>20</u>
<u>Clay</u>	<u>20</u>	<u>40</u>
<u>Clay + sand</u>	<u>40</u>	<u>60</u>
<u>blue clay</u>	<u>60</u>	<u>190</u>
<u>sand</u>	<u>190</u>	<u>220</u>

WELL LOCATION:

sec 25 T 4 S R 12  
3 miles No of Aucier  
(distance) (direction) (nearest town)

WELL PURPOSE: Home  
(home, irrigation, municipal, industrial)

CODED

WELL COMPLETION DATA:

- (1) diameter (inches) 2"
- (2) total depth (feet) 220
- (3) static water level (feet) 100 below top of ground.
- (4) casing PVC 210  
(material) (depth)  
2" if telescope see back.  
(size)
- (5) screen 10ft 210  
(length) (depth to top)  
2" PVC  
(size) (material)
- (6) pump 1 8  
(HP) (yield gpm)  
230V  
(type power)
- (7) electric log no  
(yes or no)

(organization running log)

(8) how well bottom plugged PVC sand wash

DRILLERS REMARKS: no


tailpipe

RECEIVED  
MAY 29 1985

Department of Natural Resources  
Bureau of Land & Water Resources

If well telescopes please  
sketch and show depths.

GROUND LEVEL

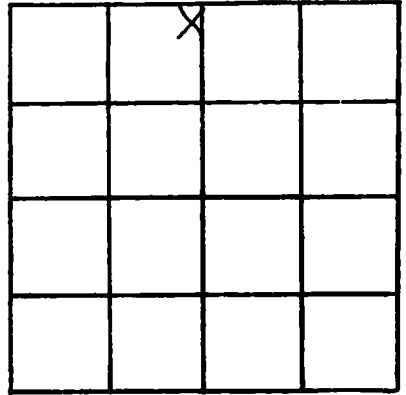

SECTION 25

Please indicate well location X.

ADDITIONAL INFORMATION

If more than one screen,  
show locations of each on sketch.