

MISSISSIPPI DEPARTMENT OF NATURAL RESOURCES

Bureau of Land and Water Resources

Southport Mall

P.O. Box 10631

Jackson, Mississippi 39209

WATER WELL DRILLERS LOG

CODED

Harrison  
B183  
4/11/85

4-11

1985

Mc Hill Well Works

Harrison

date well completed

firm name

county well located

LANDOWNER: Charles Sadler

P.O. Box 145

Saviers, Mo. 39574  
(mailing address)

WELL LOCATION:

sec. 13 T 5 N R 12 E  
(distance) miles (direction) of (nearest town)

WELL PURPOSE:

(home, irrigation, municipal, industrial)

WELL COMPLETION DATA:

- (1) diameter (inches) 2"
- (2) total depth (feet) 280'
- (3) static water level (feet) 50' below above top of ground.
- (4) casing PVC Sch 40, 270'  
(material) (depth)  
1 if telescope see back.  
(size)
- (5) screen 10', 270'  
(length) (depth to top)  
2", Sch 80 - 6 dbt  
(size) (material)
- (6) pump 1 7  
(HP) (yield gpm)  
Elec.  
(type power)
- (7) electric log (yes or no)  
  
(organization running log)
- (8) how well bottom plugged SAND  
SHARK

description of formations encountered

from

to

Mud / Sand	0	20
Sand / Mud	20	40
Mud	40	120
Mud / Sand	120	140
Mud	140	180
Mud / Sand	180	200
Sand	200	220
Mud	220	240
Mud / Sand	240	260
Sand / Gravel	260	280

RECEIVED


JUN 4 1985

DRILLERS REMARKS:

Department of Natural Resources  
Bureau of Land & Water Resources

If well telescopes please sketch and show depths.

GROUND LEVEL

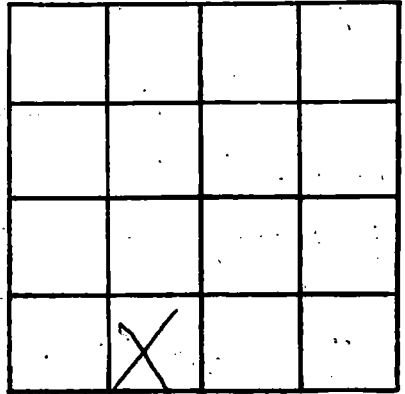

SECTION \_\_\_\_\_

Please indicate well location X.

ADDITIONAL INFORMATION

If more than one screen, show locations of each on sketch.