County: Huges 350 m	Part 1 – Driller's Log	For Office Use Only:
	Mississippi Department of Environmental Quality	Aquifer:
Permit #:	Office of Land and Water Resources	Aquifer: Well #: B-283
Driller:0 - 75'5	P.O. Box 10631	Well #:
	Jackson, MS 39289-0631	L. S. Elevation:
Date drilling completed: <u>9-26-07</u>	(601)961-5210	
	(601)354-6938 (fax)	E-log #:

Department at the above address within 30 days of com	pletion of drilling of the well or borehole.
Information on Well Owner	Well or Borehole Location
(Landowner if borehole is not for a water well) Owner Name_Bindell LAdner	Latitude: $\frac{30}{47}$ \circ $\frac{33}{47}$ $\frac{772}{42}$ Longitude: $\frac{69}{42}$ \circ $\frac{10}{42}$
Owner Name Windell LAdner 20289 Mailing Address: Hous for Caller Roll	Method of Lat/Long (circle one): Conventional Survey,
	USGS quad, Hand-held GPS, Survey-grade GPS
City State Zip Code	<u>14 Sec 34 Twn 55 Rng 12 w</u>
	Distance Direction Nearest Town Miles of
Telephone No. (22%) 832 - 561%	
Well / Bor	ehole Data
Date drilling started: $\frac{2}{2}$ Date drilling completed: $\frac{2}{2}$	Hole depth: 25° Hole diameter: 5°
Location of the source of any surface water used for drilling:	
Method of dosing and volume of Chlorine used in drilling and deve	
Logs run (circle all applicable): No log run Electric Gamma Ray Name of organization running log(s):	y Density Sonic Neutron Other:
Purpose of borehole (check one): Water Well Geotechnical/Geo	ological Investigation Ground Source Heat Pump
Seismic SurveyOther (describ	
If drilling is not related to water well constructi	on, skip the remainder of this block
Purpose of Well (check one): Home Industrial Public Supp	ly Irrigation Fish Culture Other:
If a flowing well, method of flow regulation: Valve	Other (describe)
Static Water Level:feet above & below circle one)	land surface Date measured:
Method of Measurement (circle one) <u>steel tape</u> electric tap	e air line other:
Well depth: 25° Well grouted to a depth of 10° feet Type	be of grout (circleone): Neat Cement Bentonite Mix
Casing length: <u>240</u> feet Casing diameter:	inches Type of casing:
Screen length: <u>10</u> feet Screen diameter: <u>2</u>	inches Type of screen:
Screen slot size: OOL inches Setting depth: From .	240 feet to 250 feet
Type of completion (circle all applicable): Gravel packed Under	erreamed Telescoped Open hole Natural Development
Other (describe):	0017 <i>è</i> 5 <u>200</u> 2
Top of lap pipe or reduction in casing:feet. If t	elescoped or more than one screen, describe on next page


B-283

The sketch below only required for water wells

If well telescopes, show depths on sketch. Ground Level Description of formations encountered must be provided for all wells and boreholes, unless specifically exempted by regulations

Description of Formations Encountered	From (depth) T Ground Level	75
Sand	75-	125
Clay	125	180
Sand	180	190
Clay	180	230
Sand	270	250
	-	

If more than one screen, show location of each on sketch

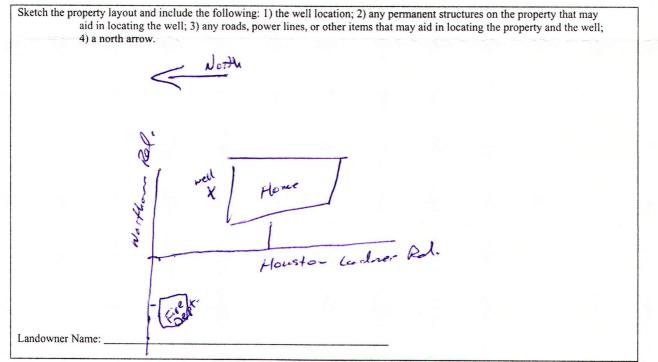

Form: OLWR-SWR-1A

I certify that the well/borehole was drilled, constructed, and completed in accordance with all applicable requirements of the Mississippi Department of Environmental Quality and the Mississippi Department of Health regulations, if applicable, and state laws.

MALVIN WAENON 0-185 9-26-07

Met Way

Print Name of Responsible Licensee and License No.

No. Date

Signature of Licensee

		ELL REPORT	
County: HARRison		Part 2 r's Completion Report	For Office Use Only:
Permit #:	Mississippi Department of Environmental Quality Office of Land and Water Resources P.O. Box 10631 Jackson, MS 39289-0631 (601)961-5210 (601)354-6938 (fax)		Aquifer: Well #: <u>B-283</u> Elevation:
Driller: 0 - 28 8			
Date completed: <u>9-27-07</u>			
Copy information from block on Part 1			
This part of the report must be completed report must be attached and both parts file	by a licensed water wel ed with the Department	l contractor or a licensed pump at the above address within 30 d	installer. A copy of Part 1 of the lays of well completion.
Well Owner Informat		We	ll Location
Owner Name: Windell 2 Add	er	Latitude: 1 30 - 33 - 782	Longitude: 89 - 10, 706
Mailing Address: 20289 Houston Ladrer BC		Method of Lat/Long (check one): Conventional Survey,	
		USGS quad, Hand-held	GPS, Survey-grade GPS
Gept MS. City State	28503	¹ / ₄ ¹ / ₄ Sec	T R
City State	Zip Code		Nearest Town
Telephone No. (228) 832 - 8648			of
Pump Type		Po	wer Type
Circle one		C	ircle one
Air Lift Jet	Submersible	Diesel Engine Gasoli	ne Engine Natural Gas
Bucket Piston	Turbine	Electric Motor Hand	Tractor PTO
Centrifugal Rotary	Flowing Well	Windmill Other	(specify):
Other (specify):		Horse Power Rating of Motor	
Date Pump Installed:		Setting Depth:	feet
Rated Pump Capacity:	Gallons Per Minute	Number of Stages:	2
Pump Test Data		Method of Me	asuring Water Level
Date Well Tested: 5 - 22 - 37			ircle one
		Air Line Electric Mea	suring Line Steel Tape
Static Water Level (A): <u>70</u> Feet Below Land Surface Pumping Water Level (B): <u>100</u> Feet Below Land Surface		Other (specify):	
Drawdown [(B) – (A)]:Feet Below Land Surface			nut in head:feet
Test Pumping Rate:Gallons Per Minute		Well yielded	
Duration of Pump Test (minimum 4 hours):	hours	feet after	REChours of pumping

Ĩ