

State Well Report
Part 1 – Driller's Log

Mississippi Department of Environmental Quality
 Office of Land and Water Resources
 P.O. Box 10631
 Jackson, MS 39289-0631
 (601)961-5210
 (601)354-6938 (fax)

For Office Use Only:

Aquifer: _____
 Well #: B-286
 L. S. Elevation: _____
 E-log #: _____

County: Harrison
 Permit #: _____
 Driller: D-785
 Date drilling completed: 3-19-08

State Law requires that this report be prepared by the license holder responsible for the work and filed with the Department at the above address within 30 days of completion of drilling of the well or borehole.

| Information on Well Owner (Landowner if borehole is not for a water well) | Well or Borehole Location |
|--|--|
| Owner Name: <u>Pam Cuevas</u> | Latitude: <u>30° 34' 26.4"</u> Longitude: <u>89° 12' 59.9"</u> |
| Mailing Address: <u>19449</u> | Method of Lat/Long (circle one): <u>Hand-held GPS</u> Survey-grade GPS |
| <u>Saucier Lizana Rd.</u> | USGS quad: _____ |
| <u>6pt. MS 39503</u> | <u>NE 1/4 NW 1/4 Sec 32 Twn 5S Rng 12W</u> |
| City State Zip Code | Distance Direction Nearest Town |
| Telephone No. () <u>861-0047</u> | _____ Miles _____ of _____ |

Well / Borehole Data

Date drilling started: 3-19 Date drilling completed: 3-19 Hole depth: 170 Hole diameter: 5"

Location of the source of any surface water used for drilling: _____
 Method of dosing and volume of Chlorine used in drilling and development: _____

Logs run (circle all applicable): No log run Electric Gamma Ray Density Sonic Neutron Other: _____
 Name of organization running log(s): _____

Purpose of borehole (check one): Water Well Geotechnical/Geological Investigation _____ Ground Source Heat Pump _____
 Seismic Survey _____ Other (describe) _____

If drilling is not related to water well construction, skip the remainder of this block

Purpose of Well (check one): Home Industrial _____ Public Supply _____ Irrigation _____ Fish Culture _____ Other: _____

If a flowing well, method of flow regulation: Valve _____ Other (describe) _____

Static Water Level: 40 feet above or below (circle one) land surface Date measured: 3-19

Method of Measurement (circle one) steel tape electric tape air line other: _____

Well depth: 170 Well grouted to a depth of _____ feet Type of grout (circle one): Neat Cement Bentonite Mix

Casing length: 160 feet Casing diameter: 2 inches Type of casing: PVC

Screen length: 10 feet Screen diameter: 2 inches Type of screen: PVC

Screen slot size: .006 inches Setting depth: From 160 feet to 170 feet

Type of completion (circle all applicable): Gravel packed Underreamed Telescoped Open hole Natural Development
 Other (describe): _____


Top of lap pipe or reduction in casing: _____ feet. *If telescoped or more than one screen, describe on next page*

Form: OLWR-SWR-1A

RECEIVED
MAR 24 2008
BY: OLWR

The sketch below only required for water wells

If well telescopes, show depths on sketch.

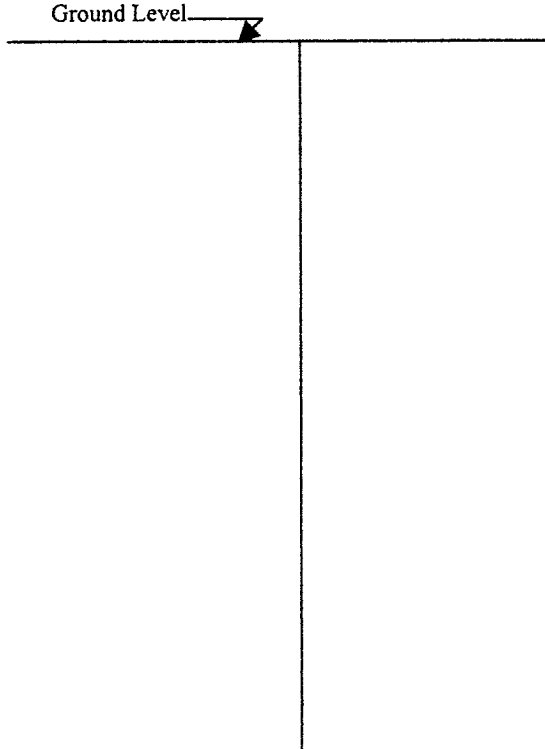


Description of formations encountered must be provided for all wells and boreholes, unless specifically exempted by regulations

| Description of Formations Encountered | From (depth) | To (depth) |
|---------------------------------------|--------------|------------|
| Clay | Ground Level | 10 |
| Sand | 10 | 60 |
| Clay | 60 | 155 |
| Sand | 155 | 170 |
| | | |
| | | |
If more than one screen, show location of each on sketch

Sketch the property layout and include the following: 1) the well location; 2) any permanent structures on the property that may aid in locating the well; 3) any roads, power lines, or other items that may aid in locating the property and the well; 4) a north arrow.

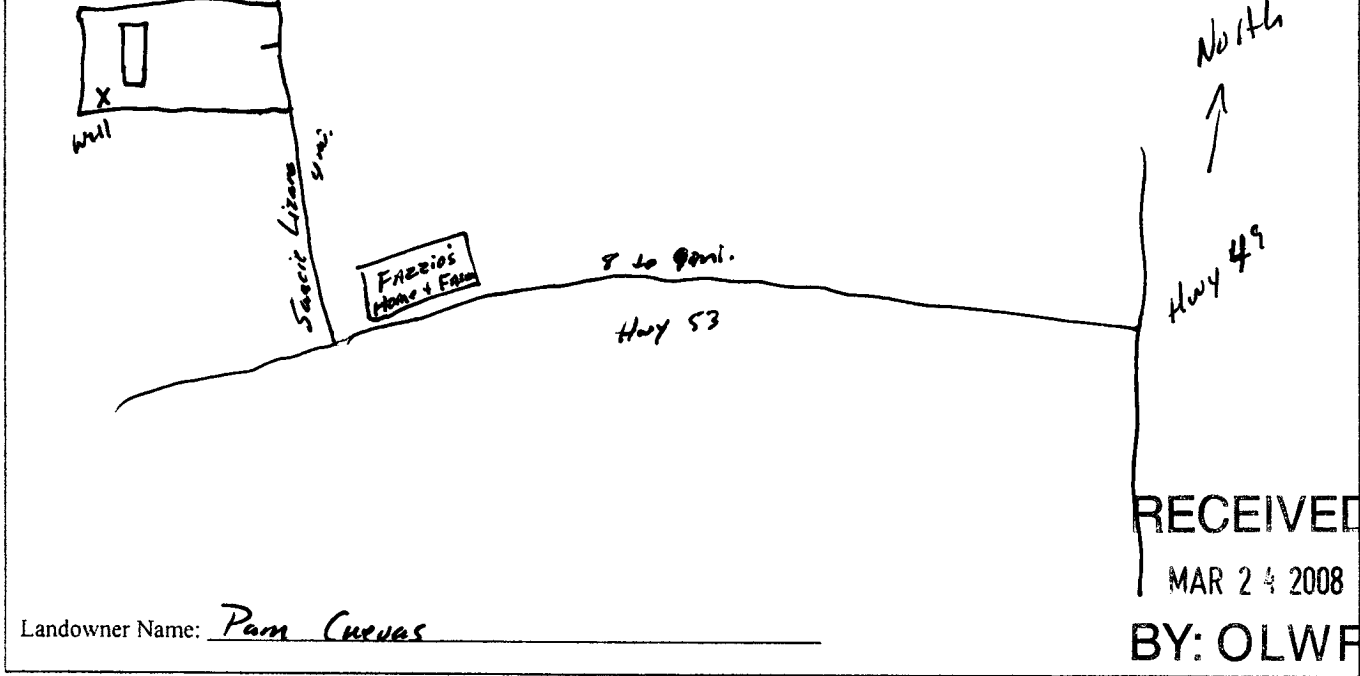

RECEIVED
 MAR 24 2008
 BY: OLWR

Form: OLWR-SWR-1A

I certify that the well/borehole was drilled, constructed, and completed in accordance with all applicable requirements of the Mississippi Department of Environmental Quality and the Mississippi Department of Health regulations, if applicable, and state laws.

Print Name of Responsible Licensee and License No. MALVIN WAGNON 0-785

Date 3-19-08

Signature of Licensee *Malvin Wagnon*

STATE WELL REPORT

Part 2

Pump Installer's Completion Report
 Mississippi Department of Environmental Quality
 Office of Land and Water Resources
 P.O. Box 10631
 Jackson, MS 39289-0631
 (601)961-5210
 (601)354-6938 (fax)

County: Harrison
 Permit #: _____
 Driller: 0-285
 Date completed: 3-20-08
Copy information from block on Part 1

For Office Use Only:

Aquifer: _____
 Well #: B-286
 Elevation: _____

This part of the report must be completed by a licensed water well contractor or a licensed pump installer. A copy of Part 1 of the report must be attached and both parts filed with the Department at the above address within 30 days of well completion.

| Well Owner Information | Well Location |
|--|---|
| Owner Name: <u>Pam Cuevas</u> | Latitude: <u>38°-34.264'</u> Longitude: <u>89°-12.979'</u> |
| Mailing Address: <u>19449</u> <u>Saucier Lizana Rd.</u> <u>Cyt. MS. 39503</u> City State Zip Code | Method of Lat/Long (check one): Conventional Survey _____ USGS quad _____, Hand-held GPS <input checked="" type="checkbox"/> , Survey-grade GPS _____ _____ 1/4 _____ 1/4 Sec _____ T _____ R _____ |
| Telephone No. (____) <u>861-0047</u> | Distance _____ Direction _____ Nearest Town _____ _____ Miles _____ of _____ |

| Pump Type Circle one | Power Type Circle one |
|---|--|
| Air Lift <input type="radio"/> Submersible <input type="radio"/> | Diesel Engine <input type="radio"/> Gasoline Engine <input type="radio"/> Natural Gas <input type="radio"/> |
| Bucket <input type="radio"/> Piston <input type="radio"/> Turbine <input type="radio"/> | <input checked="" type="radio"/> Electric Motor <input type="radio"/> Hand <input type="radio"/> Tractor PTO <input type="radio"/> |
| Centrifugal <input type="radio"/> Rotary <input type="radio"/> Flowing Well <input type="radio"/> | Windmill <input type="radio"/> Other (specify): _____ |
| Other (specify): _____ | Horse Power Rating of Motor: <u>1</u> |
| Date Pump Installed: <u>3-20-08</u> | Setting Depth: _____ feet |
| Rated Pump Capacity: _____ Gallons Per Minute | Number of Stages: <u>2</u> |

| Pump Test Data | Method of Measuring Water Level Circle one |
|--|--|
| Date Well Tested: <u>3-20-08</u> | Air Line <input type="radio"/> Electric Measuring Line <input type="radio"/> <input checked="" type="radio"/> Steel Tape |
| Static Water Level (A): <u>40</u> Feet Below Land Surface | Other (specify): _____ |
| Pumping Water Level (B): <u>20</u> Feet Below Land Surface | For flowing well, measured shut in head: _____ feet |
| Drawdown [(B) - (A)]: <u>30</u> Feet Below Land Surface | Well yielded _____ GPM with a drawdown of _____ feet after _____ hours of pumping |
| Test Pumping Rate: _____ Gallons Per Minute | |
| Duration of Pump Test (minimum 4 hours): <u>24</u> hours | |

I HEREBY CERTIFY that the above statements are true to the best of my knowledge.

MALVIN WAGNON 0-285 Malt Wagon
 Print Name of Pump Installer and License No. (if applicable) Signature of Pump Installer

Form: OLWR-SWR-1B
RECEIVED
MAR 24 2008
BY: OLWR