

MISSISSIPPI DEPARTMENT OF NATURAL RESOURCES

Bureau of Land and Water Resources

Southport Mall

P.O. Box 10631

Jackson, Mississippi 39209

WATER WELL DRILLERS LOG

Harrison
B
2001

10-7 1983
 date well completed

Frank Price
 firm name

Harrison
 county well located

LANDOWNER:	description of formations encountered	from	to
<u>James Hagbin</u> (mailing address)	<u>Top Soil</u>	<u>0</u>	<u>2</u>
WELL LOCATION: sec. <u>2</u> T <u>5</u> S R <u>12</u> W <u>2</u> miles <u>N</u> of <u>Lucas</u> (distance) (direction) (nearest town)	<u>Red Sandy Clay</u>	<u>2</u>	<u>18</u>
WELL PURPOSE: <u>HOME</u> (home, irrigation, municipal, industrial)	<u>Clay</u>	<u>18</u>	<u>48</u>
WELL COMPLETION DATA:	<u>Course Sand</u>	<u>48</u>	<u>7.3</u>
(1) diameter (inches) <u>2"</u>			
(2) total depth (feet) <u>73'</u>			
(3) static water level (feet) <u>35'</u> below top of ground.			
(4) casing <u>Plastic 68'</u> (material) (depth)			
_____ if telescope see back. (size)			
(5) screen <u>5'</u> <u>68'</u> (length) (depth to top)			
<u>2"</u> <u>Plastic</u> (size) (material)			
(6) pump <u>1</u> <u>8</u> (HP) (yield gpm)			
<u>Elect</u> (type power)			
(7) electric log <u>no</u> (yes or no)			
_____ (organization running log)			
(8) how well bottom plugged <u>B.W.V.</u>			
DRILLERS REMARKS:			


DEPT. OF NATURAL RESOURCES
 BUREAU OF LAND & WATER RESOURCES

NOV 28 1983

RECEIVED

If well telescopes please sketch and show depths.

GROUND LEVEL

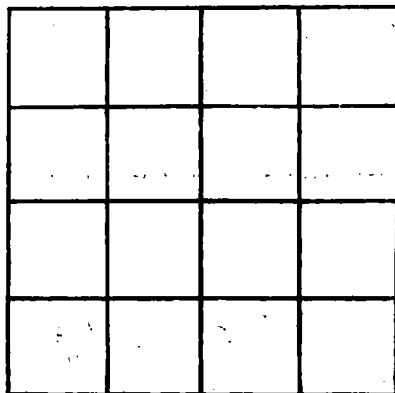

SECTION _____

Please indicate well location X.

ADDITIONAL INFORMATION

If more than one screen, show locations of each on sketch.