

MISSISSIPPI DEPARTMENT OF NATURAL RESOURCES

Bureau of Land and Water Resources

Southport Mall

P.O. Box 10631

Jackson, Mississippi 39209

WATER WELL DRILLERS LOG

HARRISON  
B 2002

Jan. 27 1984 Duncan Well Drilling Harrison  
date well completed firm name county well located

LANDOWNER: Dorothy Person  
Rt. 1 Box 47  
Saucier, Ms.  
(mailing address)

description of formations encountered	from	to
<u>top sand</u>	<u>0</u>	<u>40</u>
<u>Sand &amp; Clay</u>	<u>40</u>	<u>185</u>
<u>sand</u>	<u>185</u>	<u>210</u>
<u>Clay</u>	<u>210</u>	<u>220</u>
<u>Coarse sand</u>	<u>220</u>	<u>231</u>

WELL LOCATION:  
sec. 36 T. 5 N. R. 12 E  
5 miles S of Saucier  
(distance) (direction) (nearest town)

WELL PURPOSE: Home  
(home, irrigation, municipal, industrial)

WELL COMPLETION DATA:

- (1) diameter (inches) 2 1/2"
- (2) total depth (feet) 231'
- (3) static water level (feet) 18' below above top of ground.
- (4) casing PVC 221'  
(material) (depth)
- (size) if telescope see back.
- (5) screen 10' 221'  
(length) (depth to top)
- 2 1/2" PVC  
(size) (material)
- (6) pump 0 0  
(HP) (yield gpm)
- (type power)
- (7) electric log       
(yes or no)
- (organization running log)

(8) how well bottom plugged sand  
crack

DRILLERS REMARKS: Owner  
had his own  
pump


DEPT. OF NATURAL RESOURCES  
BUREAU OF LAND & WATER RESOURCES

FEB - 7 1984

RECEIVED

If well telescopes please sketch and show depths.

GROUND LEVEL

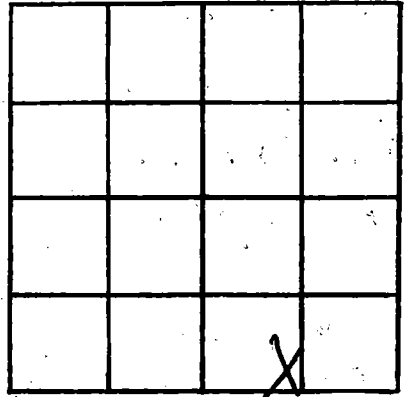

SECTION 36

Please indicate well location X.

ADDITIONAL INFORMATION

If more than one screen, show locations of each on sketch.