

MISSISSIPPI DEPARTMENT OF NATURAL RESOURCES

Bureau of Land and Water Resources

Southport Mall

P.O. Box 10631

Jackson, Mississippi 39209

WATER WELL DRILLERS LOG

COASTAL DRILLING & SERVICE CO.

Harrison  
B 2005

6/18/83 19

ROUTE 1 BOX 618

county well located

LANDOWNER: Benny Wheat

BILOXI MISS. 39532

description of formations encountered

from to

Sanvier Lign Rock

top soil

1 3

Sanvier ms  
(mailing address)

Red Clay

3 15

Super sand

15 60

Silt + Blue Clay

60 210

fine water sand

210 240

hard blue clay

240 385

fine water sand

385 415

grd water sand

415 440

WELL LOCATION:

sec 30 T S R 12 E  
S W

Biloxi's Lines  
(distance) (direction) of (nearest town)

WELL PURPOSE: home  
(home, irrigation, municipal, industrial)

WELL COMPLETION DATA:

(1) diameter (inches) 2"

(2) total depth (feet) 440'

(3) static water level (feet) 25' below above top of ground

(4) casing pc 430'  
(material) (depth)

(size) if telescope see back.

(5) screen 10' 430'  
(length) (depth to top)

2" pc  
(size) (material)

(6) pump None 13  
(HP) (yield gpm)

Ele  
(type power)

(7) electric log no  
(yes or no)

(organization running log)

(8) how well bottom plugged

2' backwash blue  
DRILLERS REMARKS: 19-B


DEPT. OF NATURAL RESOURCES  
BUREAU OF LAND & WATER RESOURCES

APR 5 1984

RECEIVED

If well telescopes please sketch and show depths.

GROUND LEVEL

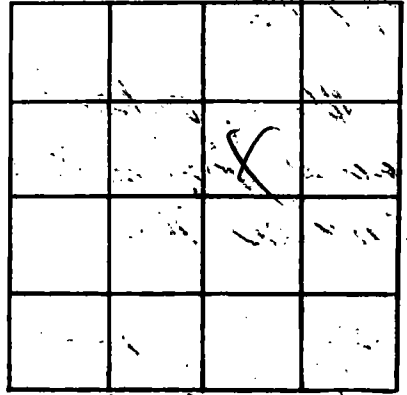

SECTION \_\_\_\_\_

Please indicate well location X.

ADDITIONAL INFORMATION

If more than one screen, show locations of each on sketch.