

MISSISSIPPI DEPARTMENT OF NATURAL RESOURCES

Bureau of Land and Water Resources

Southport Mall

P.O. Box 10631

Jackson, Mississippi 39209

WATER WELL DRILLERS LOG

Harrison  
B 2006

7-19  
date well completed

84 Frank Price  
firm name

Harrison  
county well located

LANDOWNER:	description of formations encountered	from	to
<u>Mike Laskowski</u>	<u>Top Soil</u>	<u>0</u>	<u>2</u>
(mailing address)	<u>Clay</u>	<u>2</u>	<u>325</u>
WELL LOCATION:	<u>Coarse Sand</u>	<u>325</u>	<u>350</u>
sec. <u>35</u> T. <u>5</u> R. <u>12</u> S. <u>5</u> W.			
<u>3</u> miles <u>W</u> of <u>HWY 49</u>			
(distance) (direction) (nearest town)			
WELL PURPOSE: <u>HOME</u>			
(home, irrigation, municipal, industrial)			
WELL COMPLETION DATA:			
(1) diameter (inches) <u>2"</u>			
(2) total depth (feet) <u>350</u>			
(3) static water level (feet) <u>60'</u> below top of ground.			
(4) casing <u>PVC</u> , <u>340</u>			
(material) (depth)			
(size) If telescope see back.			
(5) screen <u>10'</u> , <u>340</u>			
(length) (depth to top)			
<u>2"</u> , <u>PVC</u>			
(size) (material)			
(6) pump <u>1</u> , <u>8</u>			
(HP) (yield gpm)			
<u>Elect</u>			
(type power)			
(7) electric log <u>no</u>			
(yes or no)			
(organization running log)			
(8) how well bottom plugged <u>CBWY</u>			

DEPT. OF NATURAL RESOURCES  
BUREAU OF LAND & WATER RESOURCES


SEP - 7 1984

RECEIVED

DRILLERS REMARKS:

If well telescopes please sketch and show depths.

GROUND LEVEL

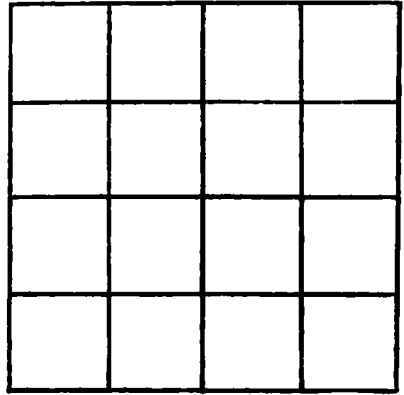

SECTION \_\_\_\_\_

Please indicate well location X.

ADDITIONAL INFORMATION

If more than one screen, show locations of each on sketch.