

MISSISSIPPI DEPARTMENT OF NATURAL RESOURCES

Bureau of Land and Water Resources

Southport Mall

P.O. Box 10631

Jackson, Mississippi 39209

WATER WELL DRILLERS LOG

Harrison
B
2007

8-18 1984
date well completed

Frost Price
firm name

Harrison
county well located

LANDOWNER:	description of formations encountered	from	to
John Alexander	Top Soil	0	2
(mailing address)	Clay	2	260
<p>WELL LOCATION:</p> <p>sec. 14 T. 5^N R. 12 E 2 miles S-W of Doula (distance) (direction) (nearest town)</p>	Course Sand	260	275
<p>WELL PURPOSE: HOME (home, irrigation, municipal, industrial)</p>			
<p>WELL COMPLETION DATA:</p> <p>(1) diameter (inches) 2</p> <p>(2) total depth (feet) 270'</p> <p>(3) static water level (feet) 60' below top of ground</p> <p>(4) casing PVC, 265' (material) (depth)</p> <p>(size) If telescope see back.</p> <p>(5) screen 10', 265' (length) (depth to top)</p> <p>2" PVC (size) (material)</p> <p>(6) pump 1 (HP) 2 (type power) (yield gpm)</p> <p>Elect (type power)</p> <p>(7) electric log no (yes or no)</p> <p>(organization running log)</p> <p>(8) how well bottom plugged DWK</p>			
<p>DRILLERS REMARKS:</p>			


DEPT. OF NATURAL RESOURCES
BUREAU OF LAND & WATER RESOURCES

SEP 7 1984

RECEIVED

If well telescopes please sketch and show depths.

GROUND LEVEL

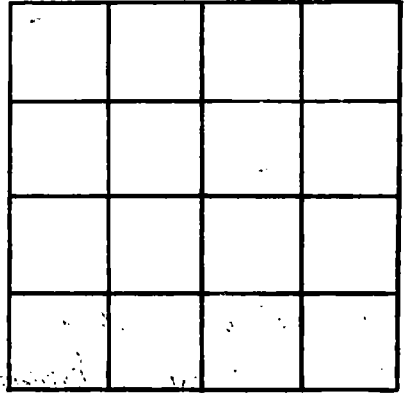

SECTION _____

Please indicate well location X.

ADDITIONAL INFORMATION

If more than one screen, show locations of each on sketch.