

Hemphill
B 2009

MISSISSIPPI
 BOARD OF WATER COMMISSIONERS
 416 North State Street
 Jackson, Mississippi 39201

WATER WELL DRILLERS LOG

8-16-84 19
 date well completed

R. J. Moore
 firm name

HARRISON
 county well located

LANDOWNER: D. V. TAYLOR
Rt 1 Box 791
Starcher, MS
 (mailing address)

WELL LOCATION:
 sec. 13 T. S N. R. 12 E
2 miles S of Starcher
 (distance) (direction) (nearest town)

description of formations encountered	from	to
<u>Red Cherty</u>	<u>0</u>	<u>15</u>
<u>Red Sand</u>	<u>15</u>	<u>30</u>
<u>White Cherty</u>	<u>30</u>	<u>100</u>
<u>Blue Cherty</u>	<u>100</u>	<u>200</u>
<u>Med Sand</u>	<u>200</u>	<u>220</u>

WELL PURPOSE: TRAILER
 (home, irrigation, municipal, industrial)

- WELL COMPLETION DATA:
- diameter (inches) 2"
 - total depth (feet) 220
 - static water level (feet) 20' ^{below} _{above} top of ground.
 - casing PVC, 220,
 (material) (depth)
 (size) If telescope see back.
 - screen 10', 220
 (length) (depth to top)
2", PVC
 (size) (material)
 - pump 1, 6
 (HP) (yield gpm)
E
 (type power)
 - electric log _____
 (yes or no)

 (organization running log)
 - how well bottom plugged Yes
Moore


DRILLERS REMARKS: _____

DEPT. OF NATURAL RESOURCES
 BUREAU OF LAND & WATER RESOURCES

NOV 13 1984
 RECEIVED

If well telescopes please sketch and show depths.

GROUND LEVEL

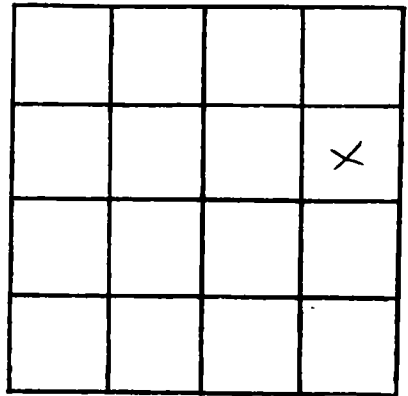

SECTION _____

Please indicate well location X.

ADDITIONAL INFORMATION

If more than one screen, show locations of each on sketch.