

MISSISSIPPI DEPARTMENT OF NATURAL RESOURCES

Bureau of Land and Water Resources

Southport Mall

P.O. Box 10631

Jackson, Mississippi 39209

WATER WELL DRILLERS LOG

Harrison
B 2013

Lyman Well Co
Harrison

9/7/84
date well completed

19

firm name

county well located

LANDOWNER: John Buckmaster
326 Kimberly Dr.
Apt 39501
(mailing address)

description of formations encountered	from	to
yellow & red clay	0	18
blue clay	18	183
Sand	184	205

WELL LOCATION:
sec. 5 T. 5 N R. 12 E
5 miles NW of Stacy
(distance) (direction) (nearest town)

WELL PURPOSE: Home
(home, irrigation, municipal, industrial)

- WELL COMPLETION DATA:
- (1) diameter (inches) 2"
 - (2) total depth (feet) 215'
 - (3) static water level (feet) 77 below top of ground. above
 - (4) casing PVC, 205'
(material) (depth)
2"
(size) if telescope see back.
 - (5) screen 10', 205'
(length) (depth to top)
2" PVC
(size) (material)
 - (6) pump 1 9
(HP) (yield gpm)
electric
(type power)
 - (7) electric log No
(yes or no)
No
(organization running log)
 - (8) how well bottom plugged sand
shark

DRILLERS REMARKS:


DEPT. OF NATURAL RESOURCES
BUREAU OF LAND & WATER RESOURCES

DEC 10 1984

RECEIVED

If well telescopes please sketch and show depths.

GROUND LEVEL

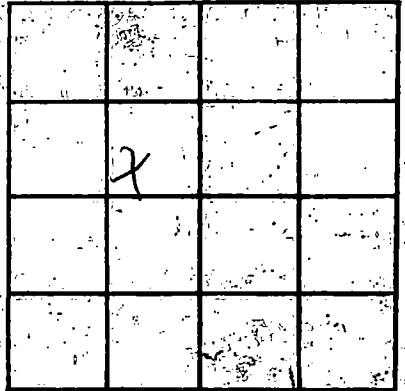

SECTION 5

Please indicate well location X.

ADDITIONAL INFORMATION

If more than one screen, show locations of each on sketch.