

**MISSISSIPPI DEPARTMENT OF NATURAL RESOURCES**  
**Bureau of Land and Water Resources**  
 Southport Mall  
 P.O. Box 10631  
 Jackson, Mississippi 39209  
**WATER WELL DRILLERS LOG**

B. 2514  
Harrison  
1228-84

12/28/84  
 date well completed

Lyman Well Co.  
 firm name


Harrison  
 county well located

LANDOWNER:	description of formations encountered	from	to
<u>Art Reader</u> <u>Frank Ladner Rd</u> <u>Saucier MS 39574</u> (mailing address)			
<b>WELL LOCATION:</b> sec <u>22</u> T <u>5</u> N R <u>12</u> E <u>5</u> miles <u>S</u> of <u>Saucier</u> (distance) (direction) (nearest town)	<u>blue mud</u>	<u>220</u>	<u>231</u>
<b>WELL PURPOSE:</b> <u>home</u> (home, irrigation, municipal, industrial)	<u>sand</u>	<u>231</u>	<u>266</u>
<b>WELL COMPLETION DATA:</b> (1) diameter (inches) <u>2"</u> (2) total depth (feet) <u>280'</u> (3) static water level (feet) <u>22'</u> <sup>below</sup> / <sub>above</sub> top of ground. (4) casing <u>PK</u> <u>270'</u> (material) (depth) <u>2"</u> If telescope see back. (size) (5) screen <u>10'</u> <u>270'</u> (length) (depth to top) <u>2"</u> <u>PVC</u> (size) (material) (6) pump <u>N/A</u> (HP) (yield gpm) (type power) (7) electric log <u>NO</u> (yes or no) <u>NO</u> (organization running log) (8) how well bottom plugged <u>sand</u> <u>shark</u>	<u>blue mud</u>	<u>260</u>	<u>280</u>
<b>DRILLERS REMARKS:</b>			

*12785  
 JW*

If well telescopes please sketch and show depths.

GROUND LEVEL

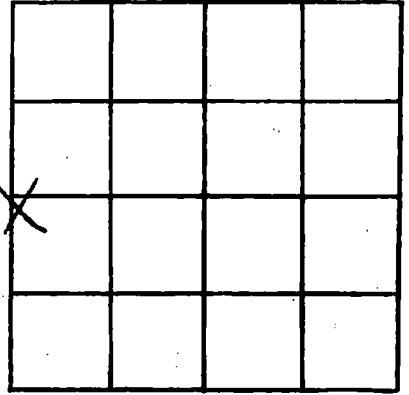

SECTION 32

Please indicate well location X.

ADDITIONAL INFORMATION

If more than one screen,  
show locations of each on sketch.