

MISSISSIPPI DEPARTMENT OF NATURAL RESOURCES

Bureau of Land and Water Resources

Southport Mall

P.O. Box 10631

Jackson, Mississippi 39209

WATER WELL DRILLERS LOG

B 2015  
 HARRISON CO.  
 1-29-85

1/29 1985 Braden Pump & Well Serv Harrison  
 date well completed firm name county well located

LANDOWNER: Water Bigert  
Pt. 3, BX 392 Lots 2  
Gulfport, Ms 39503  
 (mailing address)

WELL LOCATION:  
 sec. 11 T. 5 S. R. 12 E.  
2 miles S.W. of Saucier  
 (distance) (direction) (nearest town)

WELL PURPOSE: home  
 (home, irrigation, municipal, industrial)

WELL COMPLETION DATA:  
 (1) diameter (inches) 2"  
 (2) total depth (feet) 220  
 (3) static water level (feet) 39' below above top of ground.  
 (4) casing PVC 208  
 (material) (depth)  
2" If telescope see back.  
 (size)  
 (5) screen 10' 208  
 (length) (depth to top)  
2" PVC  
 (size) (material)  
 (6) pump 1 10  
 (HP) (yield gpm)  
230V  $\phi$   
 (type power)  
 (7) electric log no  
 (yes or no)  
 (organization running log)

description of formations encountered	from	to
	clay	0
blue clay	20	40
clay	40	60
clay with sand	60	80
clay	80	140
clay + sand	140	160
clay	160	180
clay + sand	180	200
sand	200	220

(8) how well bottom plugged PVC  
hand sharp


DRILLERS REMARKS: 2 ft  
tail pipe

RECEIVED  
 FEB 8 1985

Department of Natural Resources  
 Bureau of Land & Water Resources

If well telescopes please sketch and show depths.

GROUND LEVEL

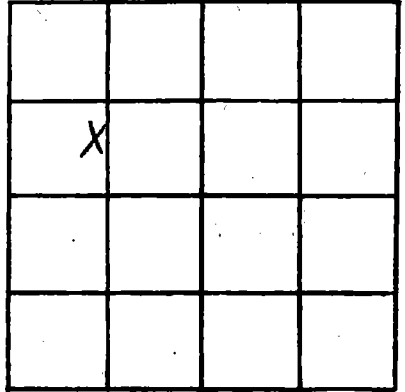

SECTION 11

Please indicate well location X.

ADDITIONAL INFORMATION

If more than one screen,  
show locations of each on sketch.