

Harrison
B 2016

BOARD OF WATER COMMISSIONERS
416 North State Street
Jackson, Mississippi 39201

WATER WELL DRILLERS LOG

2-22-85 19 R.T. Moore HARRISON
date well completed firm name county well located

LANDOWNER: MIL STANFORD
ET #1

SAUCIE MS
(mailing address)

WELL LOCATION:
sec 29 T. 5 N R. 12 E
3 miles N of LIZIYAH SCHOOL
(distance) (direction) (nearest town)

WELL PURPOSE:
(home, irrigation, municipal, industrial)

WELL COMPLETION DATA:

- (1) diameter (inches) 2"
- (2) total depth (feet) 443'
- (3) static water level (feet) 100 ^{below} _{above} top of ground.
- (4) casing PUC, 443'
(material) (depth)
2" If telescope see back.
(size)
- (5) screen 10', 443'
(length) (depth to top)
2", PUC
(size) (material)
- (6) pump 1 1/2, ↓
(HP) (yield gpm)
E
(type power)
- (7) electric log
(yes or no)

(organization running log)
- (8) how well bottom plugged BU

description of formations encountered	from	to
TOP SOIL	0	10
RED TOP SAND	10	30
RED WHITE CLAY	30	120
RED SAND	120	160
Blue Clay	160	230
COARSE SAND	230	240
Blue Clay	240	420
COARSE SAND	420	442


DRILLERS REMARKS:

RECEIVED
FEB 27 1985

Department of Natural Resources
Bureau of Land & Water Resources

If well telescopes please sketch and show depths.

GROUND LEVEL

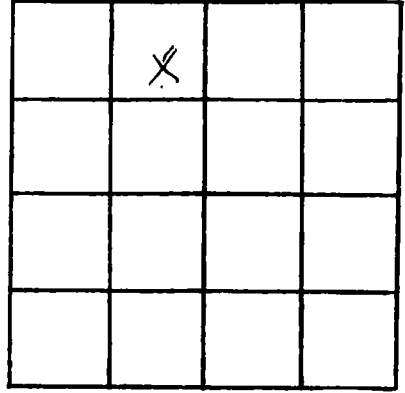

SECTION 29

Please indicate well location X.

ADDITIONAL INFORMATION

Lined area for additional information.

If more than one screen, show locations of each on sketch.