

MISSISSIPPI DEPARTMENT OF NATURAL RESOURCES

Bureau of Land and Water Resources

Southport Mall

P.O. Box 10631

Jackson, Mississippi 39209

WATER WELL DRILLERS LOG

COASTAL DRILLING & SERVICE, CO.

Harrison  
B 2017  
7-12-84

E

7/12/84

date well completed

ROUTE 1 BOX 618

HARRISON  
county well located

LANDOWNER: MARK WHITE

Huxy 53

Saucier, Miss

(mailing address)

WELL LOCATION:

sec. T 5 N R 12 E  
S W

Saucier

(distance) (direction) of (nearest town)

WELL PURPOSE:

(home, irrigation, municipal, industrial)

WELL COMPLETION DATA:

- (1) diameter (inches) 2"
- (2) total depth (feet) 160
- (3) static water level (feet) 10 below above top of ground.
- (4) casing PVC, 150,  
(material) (depth)

(size) if telescope see back.

- (5) screen 20, 130  
(length) (depth to top)
- 2', PVC  
(size) (material)

- (6) pump 1, 25 10  
(HP) (yield gpm)

ELC.  
(type power)

- (7) electric log NO  
(yes or no)

(organization running log)

- (8) how well bottom plugged 2' back  
WASH VALVE 194

description of formations encountered

from to

top soil	1	3
red clay	3	20
course white sand	20	80
sugar sand	80	130
fine water sand	130	150
good water sand	150	160

RECEIVED


JUL 22 1985

DRILLERS REMARKS:

Department of Natural Resources  
Bureau of Land & Water Resources

If well telescopes please sketch and show depths.

GROUND LEVEL

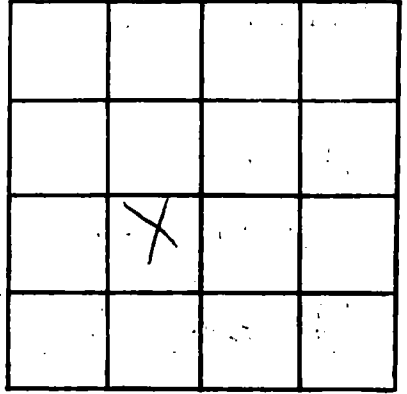

SECTION \_\_\_\_\_

Please indicate well location X.

ADDITIONAL INFORMATION

If more than one screen, show locations of each on sketch.