

MISSISSIPPI DEPARTMENT OF NATURAL RESOURCES

Bureau of Land and Water Resources

Southport Mall

P.O. Box 10631

Jackson, Mississippi 39209

WATER WELL DRILLERS LOG

HARRISON
B 2018

3/9/85 date well completed
Lyman Well Co. firm name
Harrison county well located


LANDOWNER: Daniel Sullivan Rt. 12, Box 68 Lot 138 Gulfport, Md 39503 (mailing address)	Description of formations encountered	from to
	Red clay	0 20
	Black clay	20 300
	Coarse sand	300 326
WELL LOCATION: sec. <u>32.5</u> N R. <u>12</u> E 3 miles west of Lizana (distance) (direction) (nearest town)		
WELL PURPOSE: Home (home, irrigation, municipal, industrial)		
WELL COMPLETION DATA:		
(1) diameter (inches) <u>3.25"</u>		
(2) total depth (feet) <u>326'</u>		
(3) static water level (feet) <u>76'</u> below above top of ground.		
(4) casing <u>PVC</u> , <u>3/4"</u> (material) (depth)		
<u>2"</u> if telescope see back. (size)		
(5) screen <u>10'</u> , <u>3/4"</u> (length) (depth to top)		
<u>2"</u> , <u>PVC</u> (size) (material)		
(6) pump <u>1</u> (HP), <u>10</u> (yield gpm) <u>electric</u> (type power)		
(7) electric log <u>No</u> (yes or no) <u>No</u> (organization running log)		
(8) how well bottom plugged <u>sand</u> <u>shark</u>		
DRILLERS REMARKS:		

RECEIVED
AUG 20 1985

Department of Natural Resources
Bureau of Land & Water Resources

If well telescopes please sketch and show depths.

GROUND LEVEL

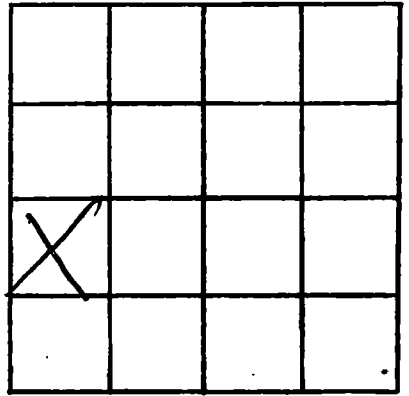

SECTION 32

Please indicate well location X.

ADDITIONAL INFORMATION

If more than one screen, show locations of each on sketch.