

MISSISSIPPI DEPARTMENT OF NATURAL RESOURCES

Bureau of Land and Water Resources

Southport Mall

P.O. Box 10631

Jackson, Mississippi 39209

WATER WELL DRILLERS LOG

B 2019
HARRISON
2-8-85

2-8

1985 *Tran Rice*

Harrison

date well completed

firm name

county well located

LANDOWNER:
Margie Bailey
(mailing address)

description of formations encountered	from	to
<i>Top Soil</i>	<i>0</i>	<i>3</i>
<i>Clay</i>	<i>3</i>	<i>270</i>
<i>Course sand</i>	<i>270</i>	<i>288</i>

WELL LOCATION:
sec *23* T *5* R *12*
1 1/2 miles *S* of *Saunder*
(distance) (direction) (nearest town)

WELL PURPOSE: *HOME*
(home, irrigation, municipal, industrial)

WELL COMPLETION DATA:

(1) diameter (inches) *2"*

(2) total depth (feet) *288'*

(3) static water level (feet) *66'* below top of ground.

(4) casing *Pvc 278'*
(material) (depth)

(size) If telescope see back.

(5) screen *10'*, *278'*
(length) (depth to top)

2", *PVC*
(size) (material)

(6) pump *1* (HP) *7* (yield gpm)

Elect
(type power)

(7) electric log *no*
(yes or no)

(organization running log)

(8) how well bottom plugged *B W V*

RECEIVED


APR 17 1985

Department of Natural Resources
Bureau of Land & Water Resources

DRILLERS REMARKS:

If well telescopes please sketch and show depths.

GROUND LEVEL

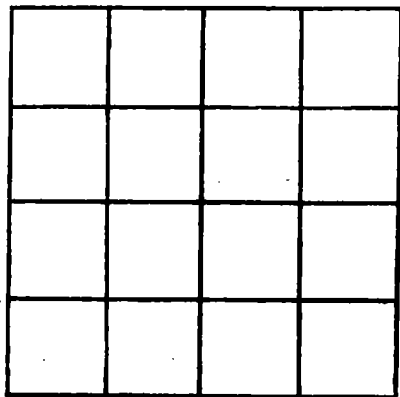

SECTION _____

Please indicate well location X.

ADDITIONAL INFORMATION

A series of horizontal lines for recording additional information, located below the 'ADDITIONAL INFORMATION' header.

If more than one screen, show locations of each on sketch.