

B ~~115~~ 2020
 HARRISON
 2-28-85

MISSISSIPPI
 BOARD OF WATER COMMISSIONERS
 416 North State Street
 Jackson, Mississippi 39201
 WATER WELL DRILLERS LOG

2-28-85 19 R. J. Moore HARRISON
 date well completed firm name county well located

LANDOWNER: BRIAN W. KNIGHT
 #3 Box 85
 DIAMOND ROAD

Shuckles, MS 39574
 (mailing address)

WELL LOCATION:
 sec. 36 T 4 N R 12 E
 2 1/2 miles NW of Shuckles
 (distance) (direction) (nearest town)

WELL PURPOSE:
 (home, irrigation, municipal, industrial)

- WELL COMPLETION DATA:
- (1) diameter (inches) 2"
 - (2) total depth (feet) 260'
 - (3) static water level (feet) 90' below top of ground.
 - (4) casing PVC, 260' (material) (depth)
 - (size) If telescope see back.
 - (5) screen 10', 260' (length) (depth to top)
 - 2" PVC (size) (material)
 - (6) pump 1 1/2 (HP) 6 (yield gpm)
 - E (type power)
 - (7) electric log (yes or no)
 - (organization running log)
 - (8) how well bottom plugged BW

description of formations encountered	from	to
TOP SOIL	0	10
Red Sand & Clay	10	60
White Clay	60	120
Blue Clay	120	230
med Sand	230	260


RECEIVED
 APR 3 - 1985

Department of Natural Resources
 Bureau of Land & Water Resources

DRILLERS REMARKS:

If well telescopes please sketch and show depths.

GROUND LEVEL

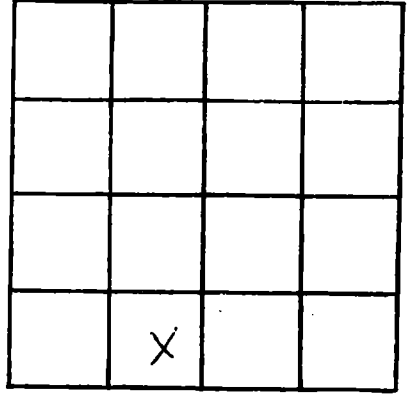

SECTION 36

Please indicate well location X.

ADDITIONAL INFORMATION

If more than one screen,
show locations of each on sketch.