

MISSISSIPPI DEPARTMENT OF NATURAL RESOURCES
Bureau of Land and Water Resources
Southport Mall
P.O. Box 10631
Jackson, Mississippi 39209
WATER WELL DRILLERS LOG

B 2022
Harrison
2-3-85

2-3-85
 date well completed

R. J. Moore
 firm name

HARRISON
 county well located

LANDOWNER: JOHN SKINNER

FRONTES ESTATES

Spaulding

(mailing address)

WELL LOCATION:

sec. 36 T 5 N R 12 E
2 miles W of Washington
 (distance) (direction) (nearest town)

WELL PURPOSE:

(home, irrigation, municipal, industrial)

WELL COMPLETION DATA:

(1) diameter (inches) 2"
 (2) total depth (feet) 600'
 (3) static water level (feet) 60' below
 top of ground. above

(4) casing Pvc 600'
 (material) (depth)

(size) If telescope see back.

(5) screen 10' 600'
 (length) (depth to top)

2" Pvc
 (size) (material)

(6) pump — —
 (HP) (yield gpm)

(type power)

(7) electric log —
 (yes or no)

(organization running log)

(8) how well bottom plugged Broken

DRILLERS REMARKS: —

description of formations encountered

from

to

TOP Soil

0 10

Reddish clay

10 30

White clay

30 60

White Reddish Sand

60 100

Blue Clay

100 300

Pvc Sand

300 510

Blue Clay

350 540

med Sand

540 560

Coarse Sand

560 600


RECEIVED

OCT 10 1985

Department of Natural Resources
 Bureau of Land & Water Resources

If well telescopes please
sketch and show depths.

GROUND LEVEL

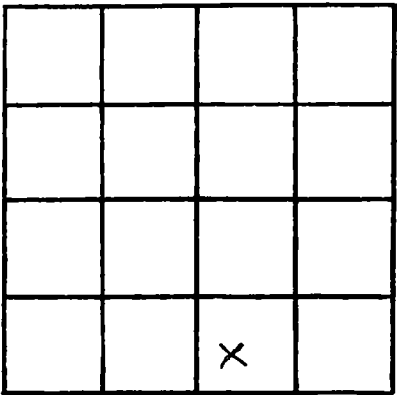

SECTION 56

Please indicate well location X.

ADDITIONAL INFORMATION

If more than one screen,
show locations of each on sketch.