

HARRISON
B 2023

MISSISSIPPI DEPARTMENT OF NATURAL RESOURCES
Bureau of Land and Water Resources
Southport Mall
P.O. Box 10631
Jackson, Mississippi 39209
WATER WELL DRILLERS LOG

3/30 1985 Braden Pump Well Inc, Harrison
date well completed firm name county well located

LANDOWNER: Billy Fayard
1240-35th St.
Shuffport, Ms. 39501
(mailing address)

WELL LOCATION:
sec. 12 T 5 R 12
1 miles SW of Saucier
(distance) (direction) (nearest town)

WELL PURPOSE: Home
(home, irrigation, municipal, industrial)

WELL COMPLETION DATA:

- (1) diameter (inches) 4x2
- (2) total depth (feet) 220
- (3) static water level (feet) 72 below above top of ground.
- (4) casing PVC, 190'
(material) (depth)
4x2 if telescope see back.
(size)
- (5) screen 10', 190'
(length) (depth to top)
2", PVC
(size) (material)
- (6) pump - 1 20
(HP) (yield gpm)
230V ϕ
(type power)
- (7) electric log no
(yes or no)
(organization running log)
- (8) how well bottom plugged PVC
sandstone


description of formations encountered	from	to
Clay	0	80
Clay + sand	80	100
Clay	100	160
Clay + sand	160	180
sand	180	200
Clay	200	220

DRILLERS REMARKS: 20 ft
tailpipe

RECEIVED
APR 28 1985

Department of Natural Resources
Bureau of Land & Water Resources

If well telescopes please sketch and show depths.

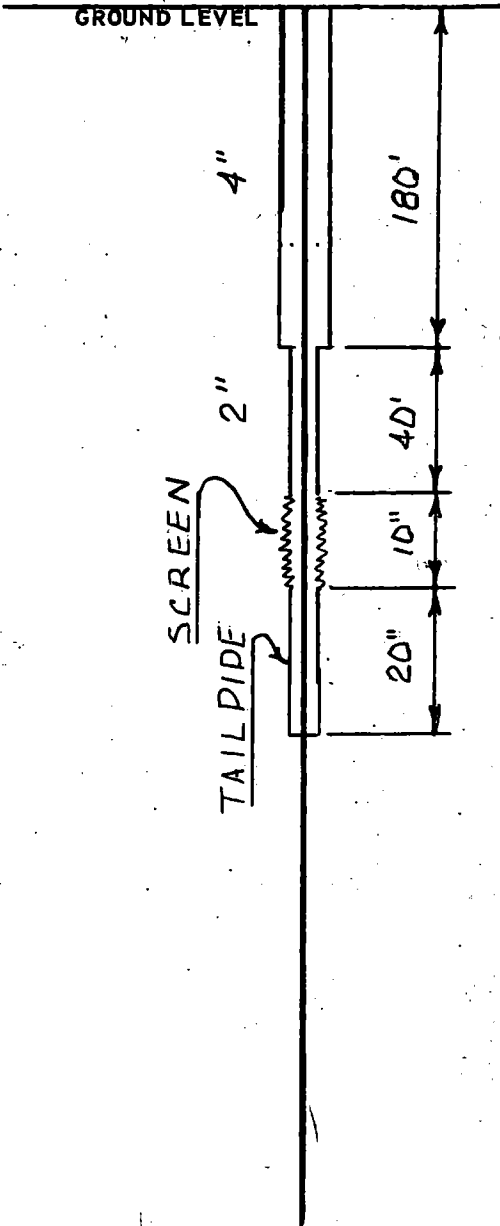

X			

SECTION 12

Please indicate well location X.

ADDITIONAL INFORMATION

If more than one screen, show locations of each on sketch.