

Harrison  
 B 2024  
 4-11-85

MISSISSIPPI DEPARTMENT OF NATURAL RESOURCES  
 Bureau of Land and Water Resources  
 Southport Mall  
 P.O. Box 10631  
 Jackson, Mississippi 39209  
**WATER WELL DRILLERS LOG**

4-11  
 date well completed

1985 Frank Price  
 firm name

Harrison  
 county well located

LANDOWNER:  
 Phyllis Miller  
 (mailing address)  
 WELL LOCATION:  
 sec. 11 T. 5 S. R. 12 W.  
 1 miles W of SAUCIER, MS  
 (distance) (direction) (nearest town)

description of formations encountered	from	to
Top Soil	0	2
Clay	2	240
Fine Sand	240	260
Coarse Sand	260	275

WELL PURPOSE: HOME  
 (home, irrigation, municipal, industrial)

WELL COMPLETION DATA:

- (1) diameter (inches) 2"
- (2) total depth (feet) 275'
- (3) static water level (feet) 70' below top of ground
- (4) casing PVC, 265' (material) (depth)
- (5) screen 10" 265' (length) (depth to top)  
 2" PVC (size) (material)
- (6) pump 1 (HP) 7 (yield gpm)  
 Elect (type power)
- (7) electric log no (yes or no)


(organization running log)

(8) how well bottom plugged  
 BWK

DRILLERS REMARKS:

If well telescopes please sketch and show depths.

GROUND LEVEL

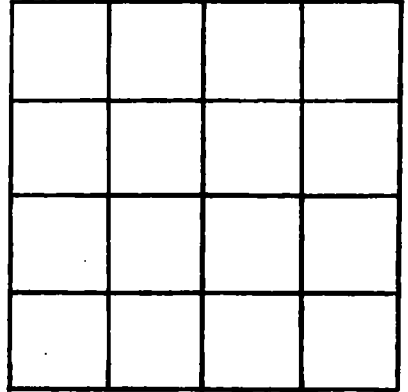

SECTION \_\_\_\_\_

Please indicate well location X.

ADDITIONAL INFORMATION

If more than one screen,  
show locations of each on sketch.