

MISSISSIPPI DEPARTMENT OF NATURAL RESOURCES
Bureau of Land and Water Resources
 Southport Mall
 P.O. Box 10631
 Jackson, Mississippi 39209
WATER WELL DRILLERS LOG

Harrison
B 2026
6-17-85

6-17-85

R. V. Moore

HARRISON

date well completed

firm name

county well located

LANDOWNER: JAMES WHITE
HICKMAN RD

Stuckler MS
 (mailing address)

WELL LOCATION:
 sec. 12 T 2E N R 12E
2 miles WEST of Stuckler
 (distance) (direction) (nearest town)

WELL PURPOSE:
 (home) irrigation, municipal, industrial

WELL COMPLETION DATA:

- (1) diameter (inches) 2"
- (2) total depth (feet) 260'
- (3) static water level (feet) 50' below above top of ground.
- (4) casing PVC, 260'
 (material) (depth)
 _____ If telescope see back.
 (size)
- (5) screen 10', 260'
 (length) (depth to top)
2", PVC
 (size) (material)
- (6) pump 1, 6
 (HP) (yield gpm)
E
 (type power)
- (7) electric log _____
 (yes or no)

 (organization running log)
- (8) how well bottom plugged RAW

description of formations encountered	depth	
	from	to
<u>TOP SOIL</u>	<u>0</u>	<u>20</u>
<u>Clay</u>	<u>20</u>	<u>250</u>
<u>fine sand</u>	<u>200</u>	<u>220</u>
<u>Med sand</u>	<u>220</u>	<u>260</u>


DRILLERS REMARKS: _____

RECEIVED
 JUL 2 - 1985

Department of Natural Resources
 Bureau of Land & Water Resources

If well telescopes please sketch and show depths.

GROUND LEVEL

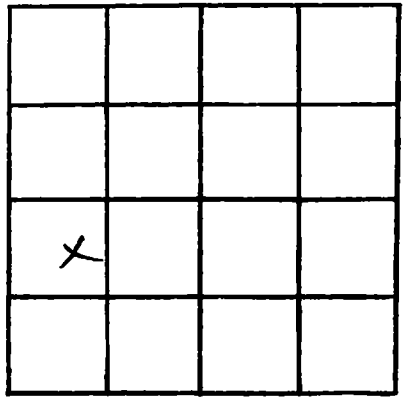

SECTION 12

Please indicate well location X.

ADDITIONAL INFORMATION

If more than one screen, show locations of each on sketch.