

MISSISSIPPI DEPARTMENT OF NATURAL RESOURCES
 Bureau of Land and Water Resources
 Southport Mall
 P.O. Box 10631
 Jackson, Mississippi 39209
WATER WELL DRILLERS LOG

Harrison
B 2027
6-15-85

6-15-85
 date well completed

R.T. Moore
 firm name

HARRIS
 county well located

LANDOWNER: E.F. Boeic
TWIN LANE +
SHAW RD

LIZIANA MS
 (mailing address)

WELL LOCATION:

sec. 5 T I N R 12 E
 (S) (W)
3 miles NE of LIZIANA
 (distance) (direction) (nearest town)

WELL PURPOSE:
 (home) Irrigation, municipal, industrial

WELL COMPLETION DATA:

- (1) diameter (inches) 2"
- (2) total depth (feet) 460'
- (3) static water level (feet) 66' ^{below} _{above} top of ground.
- (4) casing Pvc, 460'
 (material) (depth)
 (size) if telescope see back.
- (5) screen 10', 460'
 (length) (depth to top)
3", Pvc
 (size) (material)
- (6) pump E, 6
 (HP) (yield gpm)
E
 (type power)
- (7) electric log _____
 (yes or no)

 (organization running log)
- (8) how well bottom plugged few
zinc

description of formations encountered

from to

TOP SOIL	0	20
CLAY	20	460
GREEN GRAY SHL	460	460

DRILLERS REMARKS:


RECEIVED

JUL 2 - 1985

Department of Natural Resources
 Bureau of Land & Water Resources

If well telescopes please sketch and show depths.

GROUND LEVEL

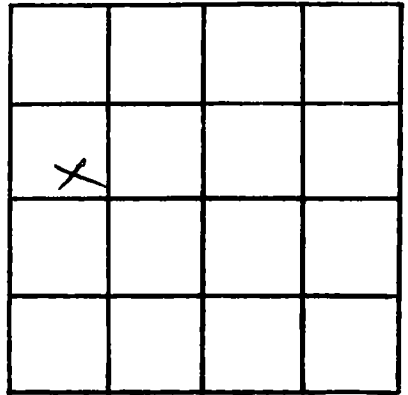

SECTION 5

Please indicate well location X.

ADDITIONAL INFORMATION

Lined area for providing additional information.

If more than one screen, show locations of each on sketch.