

MISSISSIPPI DEPARTMENT OF NATURAL RESOURCES

Bureau of Land and Water Resources

Southport Mall

P.O. Box 10631

Jackson, Mississippi 39209

WATER WELL DRILLERS LOG

B 2028
Harrison
7-1-85

7-1-85
date well completed

R. J. Moore
firm name

HARRISON
county well located

LANDOWNER: Keith Borch

description of formations encountered

from to

HICKMAN RD

SAUCIER MS
(mailing address)

Top Soil	0	10
Red Clay	10	50
White Clay	50	90
Blue Clay	90	205
Med Sand	205	250

WELL LOCATION:

sec. 11 T. 5 N. R. 12 E.
2 1/2 miles W of SAUCIER
(distance) (direction) (nearest town)

WELL PURPOSE:
(home, irrigation, municipal, industrial)

WELL COMPLETION DATA:

- (1) diameter (inches) 2"
- (2) total depth (feet) 250'
- (3) static water level (feet) 60' below top of ground.
- (4) casing PVC, 250'
(material) (depth)
(size) if telescope see back.
- (5) screen 10', 250'
(length) (depth to top)
2", PVC
(size) (material)
- (6) pump 1 (HP) 6 (yield gpm)
E
(type power)
- (7) electric log _____
(yes or no)
(organization running log)
- (8) how well bottom plugged Per draw


DRILLERS REMARKS:

RECEIVED
OCT 1 0 1985

Department of Natural Resources
Bureau of Land & Water Resources

If well telescopes please sketch and show depths.

GROUND LEVEL

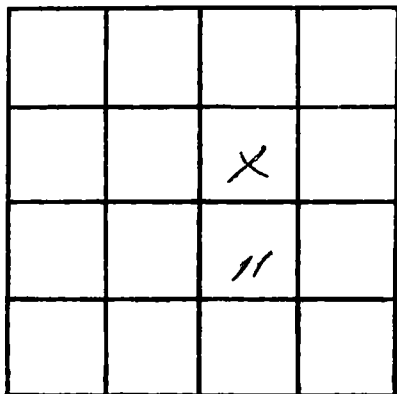

SECTION _____

Please indicate well location X.

ADDITIONAL INFORMATION

If more than one screen,
show locations of each on sketch.