

MISSISSIPPI DEPARTMENT OF NATURAL RESOURCES

Bureau of Land and Water Resources

Southport Mall

P.O. Box 10631

Jackson, Mississippi 39209

WATER WELL DRILLERS LOG

Harrison
B 2030

11-21-85

date well completed

Mc Mill Pump & Wells Harrison

firm name

county well located

LANDOWNER: Mickey Ardison

description of formations encountered

from

to

Rt. 1 Box 615

Saucier, Mo.

(mailing address)

WELL LOCATION:

sec. 13 T. 55 N. R. 12 W. S. W.  
 3 miles South, Saucier  
 (distance) (direction) (nearest town)

mud / sand	0	20
sand / gravel	20	40
Gravel / mud	40	60
mud	60	80
mud / sand	80	100
sand	100	120
hard gravel	120	130
hard gravel	140	150

WELL PURPOSE:

(home, irrigation, municipal, industrial)

WELL COMPLETION DATA:

- (1) diameter (inches) 2"
- (2) total depth (feet) 150'
- (3) static water level (feet) 6ft below top of ground.
- (4) casing 2" Sch 40 pipe (material), 140' (depth)
- (5) screen 10' (length), 140' (depth to top)  
 2" sch 80 lead pipe (size), (material)
- (6) pump 1 (HP), 8 (yield gpm)  
 elec (type power)
- (7) electric log (yes or no)
- (organization running log)
- (8) how well bottom plugged seal

RECEIVED


DEC 13 1985

Department of Natural Resources  
 Bureau of Land & Water Resources

DRILLERS REMARKS:

If well telescopes please sketch and show depths.

GROUND LEVEL

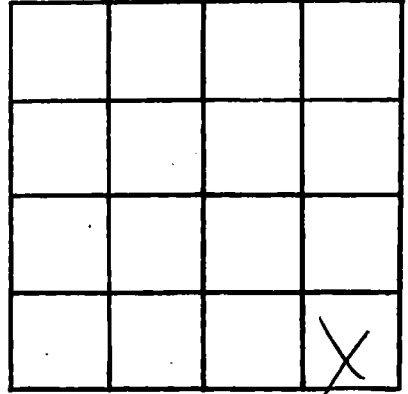

SECTION \_\_\_\_\_

Please indicate well location X.

ADDITIONAL INFORMATION

If more than one screen, show locations of each on sketch.