

MISSISSIPPI DEPARTMENT OF NATURAL RESOURCES

Bureau of Land and Water Resources

Southport Mall

P.O. Box 10631

Jackson, Mississippi 39209

WATER WELL DRILLERS LOG

HARRISON
B
2031

2-7-86 19 Coast water well Harrison
 date well completed firm name county well located

LANDOWNER	Description of formations encountered	from	to
<u>Buckwater</u>	<u>Top Soil</u>	<u>0</u>	<u>1</u>
<u>(unknown)</u>	<u>Red Sand</u>	<u>1</u>	<u>6</u>
<u>N. Gulfport, ms</u> <u>(mailing address) 39501</u>	<u>Red Clay</u>	<u>6</u>	<u>15</u>
WELL LOCATION:	<u>Red Sand</u>	<u>15</u>	<u>28</u>
sec. <u>16</u> T. <u>5</u> N. R. <u>12</u> E.	<u>Red Clay</u>	<u>28</u>	<u>31</u>
<u>3</u> miles <u>W</u> of <u>Lucas</u>	<u>White Coarse Sand</u>	<u>31</u>	<u>60</u>
(distance) (direction) (nearest town)	<u>Blue Clay</u>	<u>60</u>	<u>210</u>
WELL PURPOSE: <u>Home</u>	<u>Gray Fine Sand</u>	<u>210</u>	<u>215</u>
(home, irrigation, municipal, industrial)	<u>Blue Clay</u>	<u>215</u>	<u>255</u>
WELL COMPLETION DATA:	<u>Gray med Sand</u>	<u>255</u>	<u>285</u>
(1) diameter (inches) <u>2"</u>			
(2) total depth (feet) <u>285</u>			
(3) static water level (feet) <u>75</u> below top of ground.			
(4) casing <u>PVC</u> (material), <u>270</u> (depth)			
<u>2"</u> (size) if telescope see back.			
(5) screen <u>10ft</u> , <u>270ft</u> (length), (depth to top)			
<u>2"</u> (size) <u>PVC</u> (material)			
(6) pump <u>1/2 HP</u> (type power), (yield gpm)			
<u>Electric</u>			
(7) electric log <u>NO</u> (yes or no)			
(organization running log)			
(8) how well bottom plugged <u>Backwash valve</u>			
DRILLERS REMARKS:			
<u>5ft 2" tailpipe</u>			


RECEIVED

MAR 7 - 1986

Department of Natural Resources
 Bureau of Land & Water Resources

If well telescopes please sketch and show depths.

GROUND LEVEL

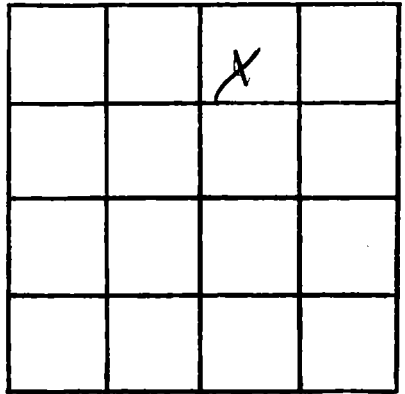

SECTION 10

Please indicate well location X.

ADDITIONAL INFORMATION

If more than one screen,
show locations of each on sketch.