

MISSISSIPPI DEPARTMENT OF NATURAL RESOURCES

Bureau of Land and Water Resources

Southport Mall

P.O. Box 10631

Jackson, Mississippi 39209

WATER WELL DRILLERS LOG

Harrison
B2032

3-1-86 19
date well completed

McNeil Pump & Well
firm name

Harrison
county well located


LANDOWNER: <u>Bruce Miller</u>	description of formations encountered	from	to
<u>3316 Johnson Drive</u> <u>Hgt. Ms. 39501</u> (mailing address)	<u>mud</u> <u>sand</u> <u>mud</u> <u>sand</u>	<u>0</u> <u>60</u> <u>60</u> <u>80</u>	<u>60</u> <u>80</u> <u>140</u> <u>140</u>
WELL LOCATION:			
sec. <u>34</u> T <u>4</u> N R <u>12</u> E <u>3</u> miles <u>N</u> of <u>Saucier</u> (distance) (direction) (nearest town)			
WELL PURPOSE:			
<u>(home, irrigation, municipal, industrial)</u>			
WELL COMPLETION DATA:			
(1) diameter (inches) <u>2"</u>			
(2) total depth (feet) <u>280'</u>			
(3) static water level (feet) _____ below above top of ground.			
(4) casing <u>Sch. 40 P.C.</u> <u>270'</u> (material) (depth)			
_____ If telescope see back. (size)			
(5) screen <u>10'</u> (length) (depth to top)			
<u>1"</u> <u>Sch. 80</u> (size) (material)			
(6) pump <u>1</u> <u>4</u> (HP) (yield gpm)			
<u>electric</u> (type power)			
(7) electric log <u>no</u> (yes or no)			
(organization running log)			
(8) how well bottom plugged <u>and</u> <u>shard</u>			
DRILLERS REMARKS:			



Department
Bureau of Land and Water Resources

If well telescopes please sketch and show depths.

GROUND LEVEL

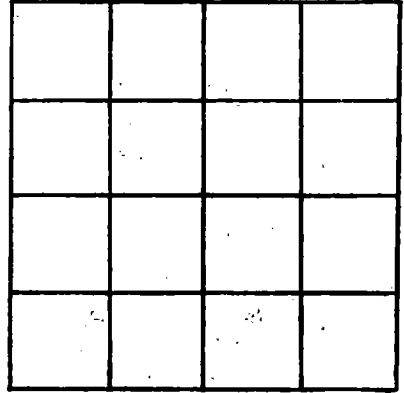

SECTION _____

Please indicate well location X.

ADDITIONAL INFORMATION

If more than one screen, show locations of each on sketch.