

MISSISSIPPI DEPARTMENT OF NATURAL RESOURCES

Bureau of Land and Water Resources

Southport Mall

P.O. Box 10631

Jackson, Mississippi 39209

WATER WELL DRILLERS LOG

Harrison  
B2033

1-9-86 19 86  
date well completed

McMill Pump & Well  
firm name

Harrison  
county well located

LANDOWNER: Clarence Howard  
P.O. Box 28  
Aurora, Ms.  
(mailing address)

description of formations encountered	from	to
<u> Mud</u>	<u>0</u>	<u>120</u>
<u> sand</u>	<u>120</u>	<u>160</u>
<u> Mud</u>	<u>160</u>	<u>230</u>
<u> sand</u>	<u>230</u>	<u>300</u>

WELL LOCATION:  
sec. 35 T 4 N R 2E  
5 W  
miles \_\_\_\_\_ of \_\_\_\_\_  
(distance) (direction) (nearest town)

WELL PURPOSE:  
(home, irrigation, municipal, industrial)

WELL COMPLETION DATA:

(1) diameter (inches) 2"

(2) total depth (feet) 300'

(3) static water level (feet) 80' below above top of ground.

(4) casing 2" Sch 40 290'  
(material) (depth)


\_\_\_\_\_ if telescope see back.  
(size)

(5) screen 10' (length) (depth to tap)  
2" (size) Sch 40 (material)

(6) pump 1 (HP) 9 (yield gpm)  
electric (type power)

(7) electric log \_\_\_\_\_ (yes or no)  
\_\_\_\_\_  
(organization running log)

(8) how well bottom plugged do. 1  
head

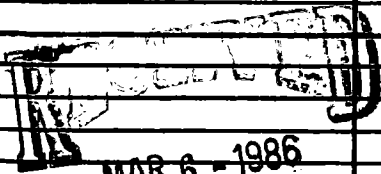

MAR 6 - 1986

Department of Natural Resources  
Bureau of Land & Water Resources

DRILLERS REMARKS:

If well telescopes please sketch and show depths.

GROUND LEVEL



SECTION \_\_\_\_\_

Please indicate well location X.

ADDITIONAL INFORMATION

If more than one screen, show locations of each on sketch.