

MISSISSIPPI DEPARTMENT OF NATURAL RESOURCES

Bureau of Land and Water Resources

Southport Mall

P.O. Box 10631

Jackson, Mississippi 39209

WATER WELL DRILLERS LOG

Harrison  
B 2034

Feb. 17 - 86 1986 McGee Pump & Well Harrison  
date well completed firm name county well located

LANDOWNER: Cornine Van Court  
Rt. 3 Box 176  
Sauces, Mo.  
(mailing address)

description of formations encountered	from to	
<u>Mud</u>	<u>0</u>	<u>252</u>
<u>C. Sand</u>	<u>252</u>	<u>290</u>

WELL LOCATION:  
sec. 10 T. 5 N. R. 12 E.  
3 W  
1 miles W of Sauces  
(distance) (direction) (nearest town)

WELL PURPOSE:  
Home, Irrigation, municipal, industrial

WELL COMPLETION DATA:

(1) diameter (inches) 2"

(2) total depth (feet) 290'

(3) static water level (feet) \_\_\_\_\_ below above top of ground.

(4) casing 3ch. 40 280'  
(material) (depth)  
2 If telescope see back.  
(size)

(5) screen 10ft  
(length) (depth to top)  
2" 3ch. 80  
(size) (material)

(6) pump 1 9  
(HP) (yield gpm)  
electric  
(type power)

(7) electric log —  
(yes or no)  
(organization running log)

(8) how well bottom plugged. Sand Seal.


DRILLERS REMARKS:

**RECEIVED**  
MAR 6 - 1986

Department of Natural Resources  
Bureau of Land & Water Resources

If well telescopes please sketch and show depths.

GROUND LEVEL

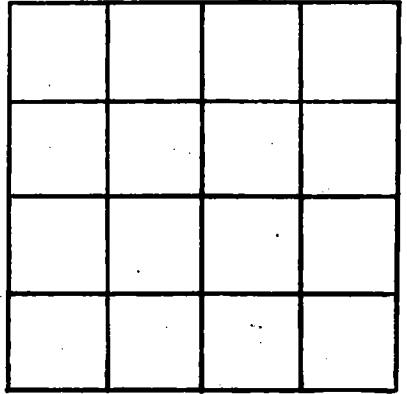

SECTION \_\_\_\_\_

Please indicate well location X.

ADDITIONAL INFORMATION

If more than one screen,  
show locations of each on sketch.