

MISSISSIPPI DEPARTMENT OF NATURAL RESOURCES

Bureau of Land and Water Resources

Southport Mall

P.O. Box 10631

Jackson, Mississippi 39209

WATER WELL DRILLERS LOG

HARRISON  
B 2037

6/22/85 19 Lyman Well Co. Harrison  
date well completed firm name county well located

LANDOWNER: Sandy Davenport  
Rt. 2, Box 104  
Saucier, Md 39574  
(mailing address)

description of formations encountered	from	to
	<u>white clay</u>	<u>0</u>
<u>Red clay</u>	<u>40</u>	<u>80</u>
<u>gray clay</u>	<u>80</u>	<u>135</u>
<u>low sand</u>	<u>135</u>	<u>145</u>

WELL LOCATION:

sec. 13 T 5 N R. 12 E W  
3 miles South of Saucier  
(distance) (direction) (nearest town)

WELL PURPOSE: None  
(home, irrigation, municipal, industrial)

WELL COMPLETION DATA:

- (1) diameter (inches) 2"
- (2) total depth (feet) 145'
- (3) static water level (feet) 50' below above top of ground.
- (4) casing PVC, 135'  
(material) (depth)
- 2"  
(size) if telescope see back.
- (5) screen 10', 135'  
(length) (depth to top)
- 2", PVC  
(size) (material)
- (6) pump 1 (HP) 12 (yield gpm)  
electric  
(type power)
- (7) electric log No  
(yes or no)  
No  
(organization running log)
- (8) how well bottom plugged sand  
shark


**RECEIVED**  
APR - 9 1986

DRILLERS REMARKS:

Department of Natural Resources  
Bureau of Land & Water Resources

If well telescopes please sketch and show depths.

GROUND LEVEL

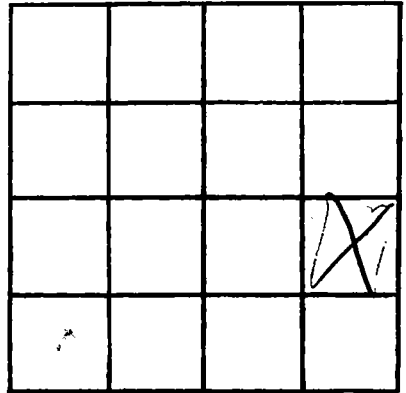

SECTION 73

Please indicate well location X.

ADDITIONAL INFORMATION

If more than one screen, show locations of each on sketch.