

MISSISSIPPI DEPARTMENT OF NATURAL RESOURCES

Bureau of Land and Water Resources

Southport Mall

P.O. Box 10631

Jackson, Mississippi 39209

WATER WELL DRILLERS LOG

HARRISON  
B2038

11/4/85 19 Lyman Well Harrison  
date well completed firm name county well located

LANDOWNER: Ernest Allen

description of formations encountered

from to

P.O. Box 3591

Red clay

0 40

Southport, MS 39503  
(mailing address)

Blue clay

40 180

WELL LOCATION:

Sand

180 200

sec. 4 T. 5 N. R. 12 E.  
7 miles SW of Southport  
(distance) (direction) (nearest town)

WELL PURPOSE: Home  
(home, irrigation, municipal, industrial)

WELL COMPLETION DATA:

(1) diameter (inches) 2"  
(2) total depth (feet) 200'  
(3) static water level (feet) 82' below top of ground.

(4) casing PVC, 190'  
(material) (depth)  
2"  
(size) if telescope see back.

(5) screen 10', 190'  
(length) (depth to top)  
2", PVC  
(size) (material)

(6) pump 1, 8  
(HP) (yield gpm)  
electric  
(type power)

(7) electric log NO  
(yes or no)  
NO  
(organization running log)

(8) how well bottom plugged sand  
shark


DRILLERS REMARKS:

RECEIVED  
APR 9 1986

Department of Natural Resources

If well telescopes please sketch and show depths.

GROUND LEVEL

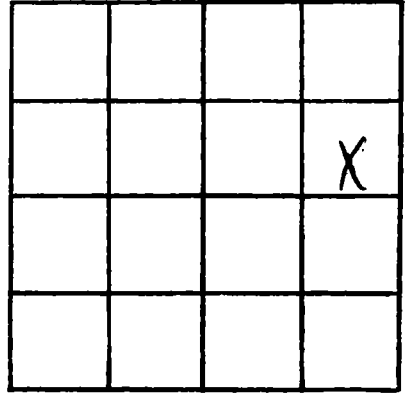

SECTION

4

Please indicate well location X.

ADDITIONAL INFORMATION

If more than one screen,  
show locations of each on sketch.