

MISSISSIPPI DEPARTMENT OF NATURAL RESOURCES

Bureau of Land and Water Resources

Southport Mall

P.O. Box 10631

Jackson, Mississippi 39209

WATER WELL DRILLERS LOG

HARRISON
B
2040

5-7-86 19
 date well completed

R J Moore
 firm name

HARRISON
 county well located

LANDOWNER: HORACE CURT

WEST CURETOWN RD

Structure

(mailing address)

WELL LOCATION:

sec. 20 T. 5 N. R. 12 E.

8 miles W of LORETAN
 (distance) (direction) (nearest town)

WELL PURPOSE:

(Home Irrigation, municipal, industrial)

WELL COMPLETION DATA:

- (1) diameter (inches) 2"
 (2) total depth (feet) 240'
 (3) static water level (feet) 80' below above
 top of ground.
 (4) casing PVC 240
 (material) (depth)

(size) if telescope see back.

- (5) screen 10' 240'
 (length) (depth to top)
2" PVC
 (size) (material)

- (6) pump 1 1/2 ?
 (HP) (yield gpm)
E
 (type power)

- (7) electric log _____
 (yes or no)

(organization running log)

- (8) how well bottom plugged BW
none

description of formations encountered

from to

<u>Red Clay</u>	<u>0</u>	<u>20</u>
<u>Red & white Clay</u>	<u>0</u>	<u>60</u>
<u>Blue Clay</u>	<u>60</u>	<u>200</u>
<u>Med Sand</u>	<u>200</u>	<u>226</u>
<u>Coar. Sand</u>	<u>220</u>	<u>246</u>

DRILLERS REMARKS:


RECEIVED

MAY 22 1986

Department of Natural Resources
 Bureau of Land & Water Resources

If well telescopes please sketch and show depths.

GROUND LEVEL

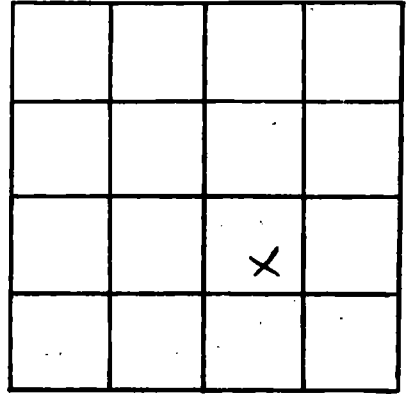

SECTION 20

Please indicate well location X.

ADDITIONAL INFORMATION

If more than one screen, show locations of each on sketch.