

MISSISSIPPI DEPARTMENT OF NATURAL RESOURCES

Bureau of Land and Water Resources

Southport Mall

P.O. Box 10631

Jackson, Mississippi 39209

WATER WELL DRILLERS LOG

Harrison
B2041

1-23 1986 Parrell Anderson Harrison
date well completed firm name county well located

LANDOWNER: Larry Wedgeworth

Saucier

Mis.
(mailing address)

WELL LOCATION:

sec. 25 T 5 N R 12 E
S W
4 miles S of Saucier
(distance) (direction) (nearest town)


WELL PURPOSE: HOME
(home, irrigation, municipal, industrial)

WELL COMPLETION DATA:

- (1) diameter (inches) 2
- (2) total depth (feet) 127
- (3) static water level (feet) 40 below above top of ground.
- (4) casing PVC, 122,
(material) (depth)
 if telescope see back.
(size)
- (5) screen 5, 122
(length) (depth to top)
2, PVC
(size) (material)
- (6) pump 1, 10
(HP) (yield gpm)
Elac
(type power)
- (7) electric log no
(yes or no)

(organization running log)
- (8) how well bottom plugged Cap

description of formations encountered	from to	
<u>Top Soil</u>	<u>0</u>	<u>2</u>
<u>Clay</u>	<u>2</u>	<u>16</u>
<u>Sand</u>	<u>16</u>	<u>24</u>
<u>Blue Clay</u>	<u>24</u>	<u>96</u>
<u>Sand</u>	<u>96</u>	<u>127</u>

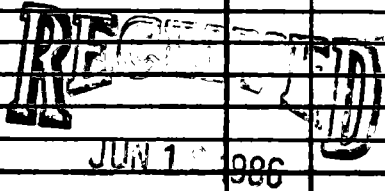


Department of Natural Resources
Bureau of Land & Water Resources

DRILLERS REMARKS:

If well telescopes please sketch and show depths.

GROUND LEVEL

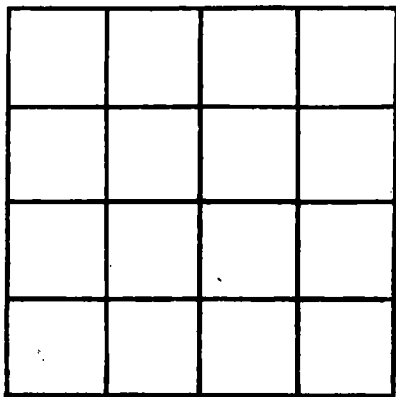

SECTION _____

Please indicate well location X.

ADDITIONAL INFORMATION

A series of horizontal lines providing space for additional information.

If more than one screen, show locations of each on sketch.