

MISSISSIPPI DEPARTMENT OF NATURAL RESOURCES

Bureau of Land and Water Resources

Southport Mall

P.O. Box 10631

Jackson, Mississippi 39209

WATER WELL DRILLERS LOG

HARRISON
JB 2042

10-13-86

McMill Pump & Wells

Harrison

date well completed

firm name

county well located

LANDOWNER: Mark Applebites

description of formations encountered

from

to

P.O. Box 3291

Apt. 414 39505
(mailing address)

WELL LOCATION:

sec. 34 T 4 N R 12 E

3 miles SW of Franklin
(distance) (direction) (nearest town)

WELL PURPOSE: home
(~~home~~) irrigation, municipal, industrial

WELL COMPLETION DATA:

- (1) diameter (inches) 2"
- (2) total depth (feet) 300
- (3) static water level (feet) 160' ^{below}/_{above} top of ground.
- (4) casing PVC 300'
(material) (depth)
2" if telescope see back.
(size)
- (5) screen 10' Bottom
(length) (depth to top)
2" PVC
(size) (material)
- (6) pump 1 9
(HP) (yield gpm)
Electric
(type power)
- (7) electric log no
(yes or no)

(organization running log)

(8) how well bottom plugged Seal

RECEIVED


AUG 7 1986

Department of Natural Resources
Bureau of Land & Water Resources

DRILLERS REMARKS:

If well telescopes please sketch and show depths.

GROUND LEVEL

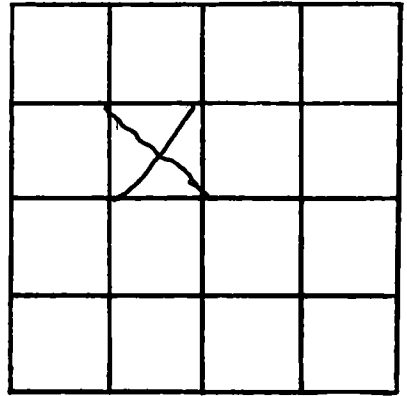

SECTION _____

Please indicate well location X.

ADDITIONAL INFORMATION

If more than one screen, show locations of each on sketch.