

MISSISSIPPI DEPARTMENT OF NATURAL RESOURCES

Bureau of Land and Water Resources

Southport Mall

P.O. Box 10631

Jackson, Mississippi 39209

WATER WELL DRILLERS LOG

HARRISON
B 243

June 10 - 1986 date well completed McGill Pump & Well firm name Harrison county well located

LANDOWNER: Kirsty Anderson
Best Pal
Saucier, Ms.
(mailing address)

description of formations encountered	from	to
<u>Mud</u>	<u>0</u>	<u>40</u>
<u>sand</u>	<u>10</u>	<u>50</u>
<u>mud</u>	<u>50</u>	<u>160</u>
<u>Sand</u>	<u>160</u>	<u>190</u>

WELL LOCATION:
sec. 36 T-4 N R-12 E
3 miles South of Saucier
(distance) (direction) (nearest town)

WELL PURPOSE: home
(home, irrigation, municipal, industrial)

- WELL COMPLETION DATA:
- (1) diameter (inches) 2"
 - (2) total depth (feet) 190'
 - (3) static water level (feet) 30' below above top of ground.
 - (4) casing PVC, 180',
(material) (depth)
2"
(size) if telescope see back.
 - (5) screen 10', Bottom
(length) (depth to top)
2" PVC
(size) (material)
 - (6) pump 1 11
(HP) (yield gpm)
electric
(type power)
 - (7) electric log no
(yes or no)

(organization running log)
 - (8) how well bottom plugged Seal


RECEIVED
AUG 7 1986

Department of Natural Resources
Bureau of Land & Water Resources

DRILLERS REMARKS:

If well telescopes please sketch and show depths.

GROUND LEVEL

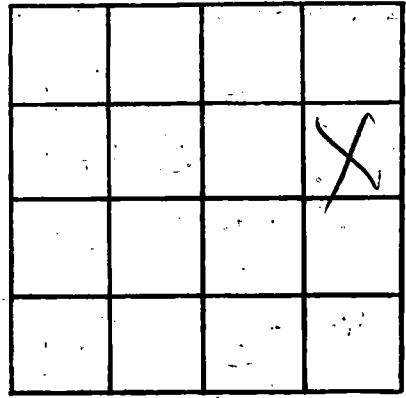

SECTION _____

Please indicate well location X.

ADDITIONAL INFORMATION

Lined area for additional information.

If more than one screen, show locations of each on sketch.